# 1950
# MAPS
# ERIE
# COUNTY
# NY

1950 OFFICE MAP

OFFICE COPY 1950

# MAP OF
# THE TOWN OF
# ALDEN
## ERIE COUNTY, N.Y.

Compiled by
ERIE COUNTY PLANNING BOARD
1948

#76420

Note This map is compiled from deeds recorded in the Erie County Clerks Office. Lots of less than one acre are not shown.

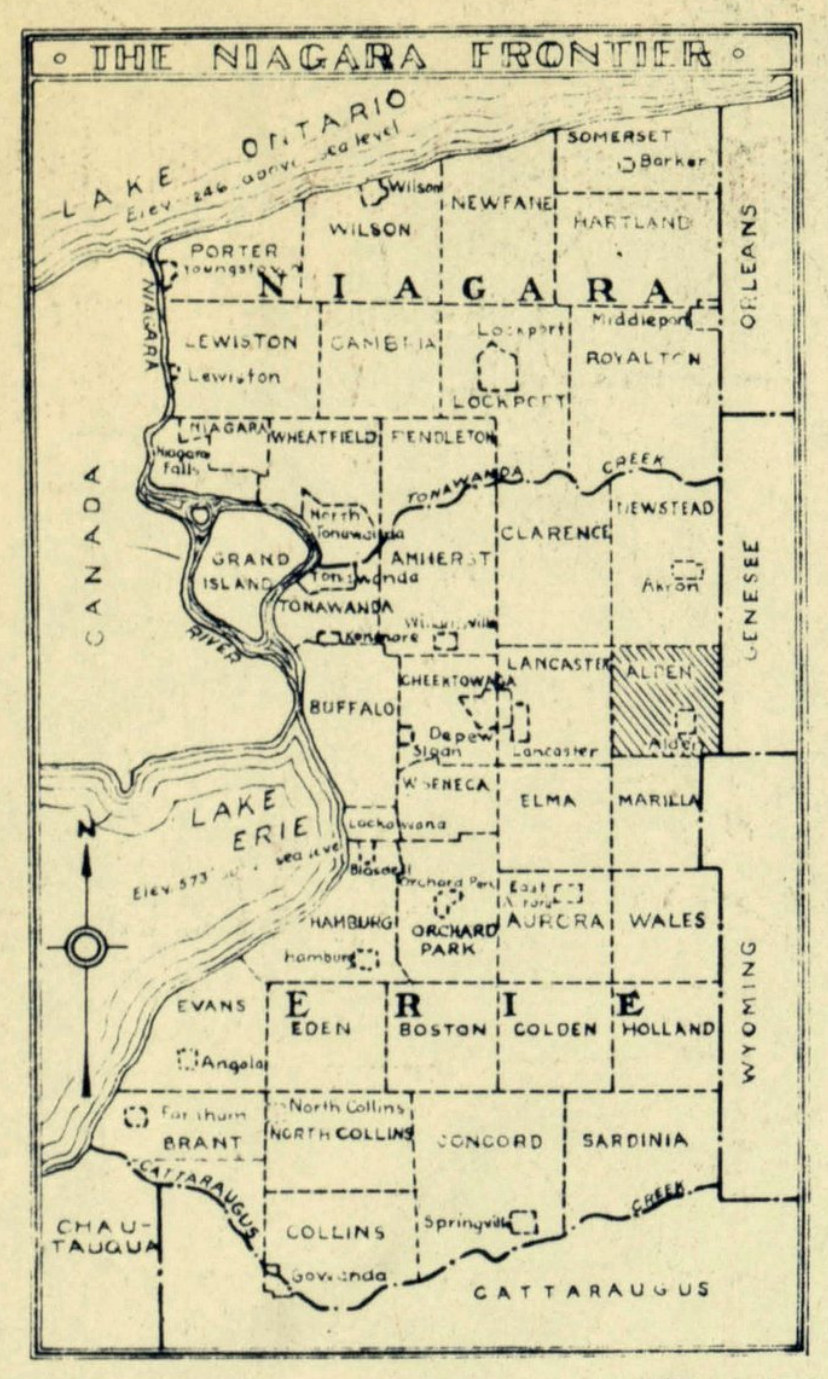

**LEGEND**

- COUNTY LINE
- TOWNSHIP & RANGE LINE
- CITY & VILLAGE LINE
- FARM OR GREAT LOT LINE
- PROPERTY LINE
- STATE HIGHWAY
- COUNTY HIGHWAY
- TOWN HIGHWAY
- RAILROADS – Two or more tracks
- STREAMS

SCALE
Feet
0 1000 2000 3000 4000 5000
Miles

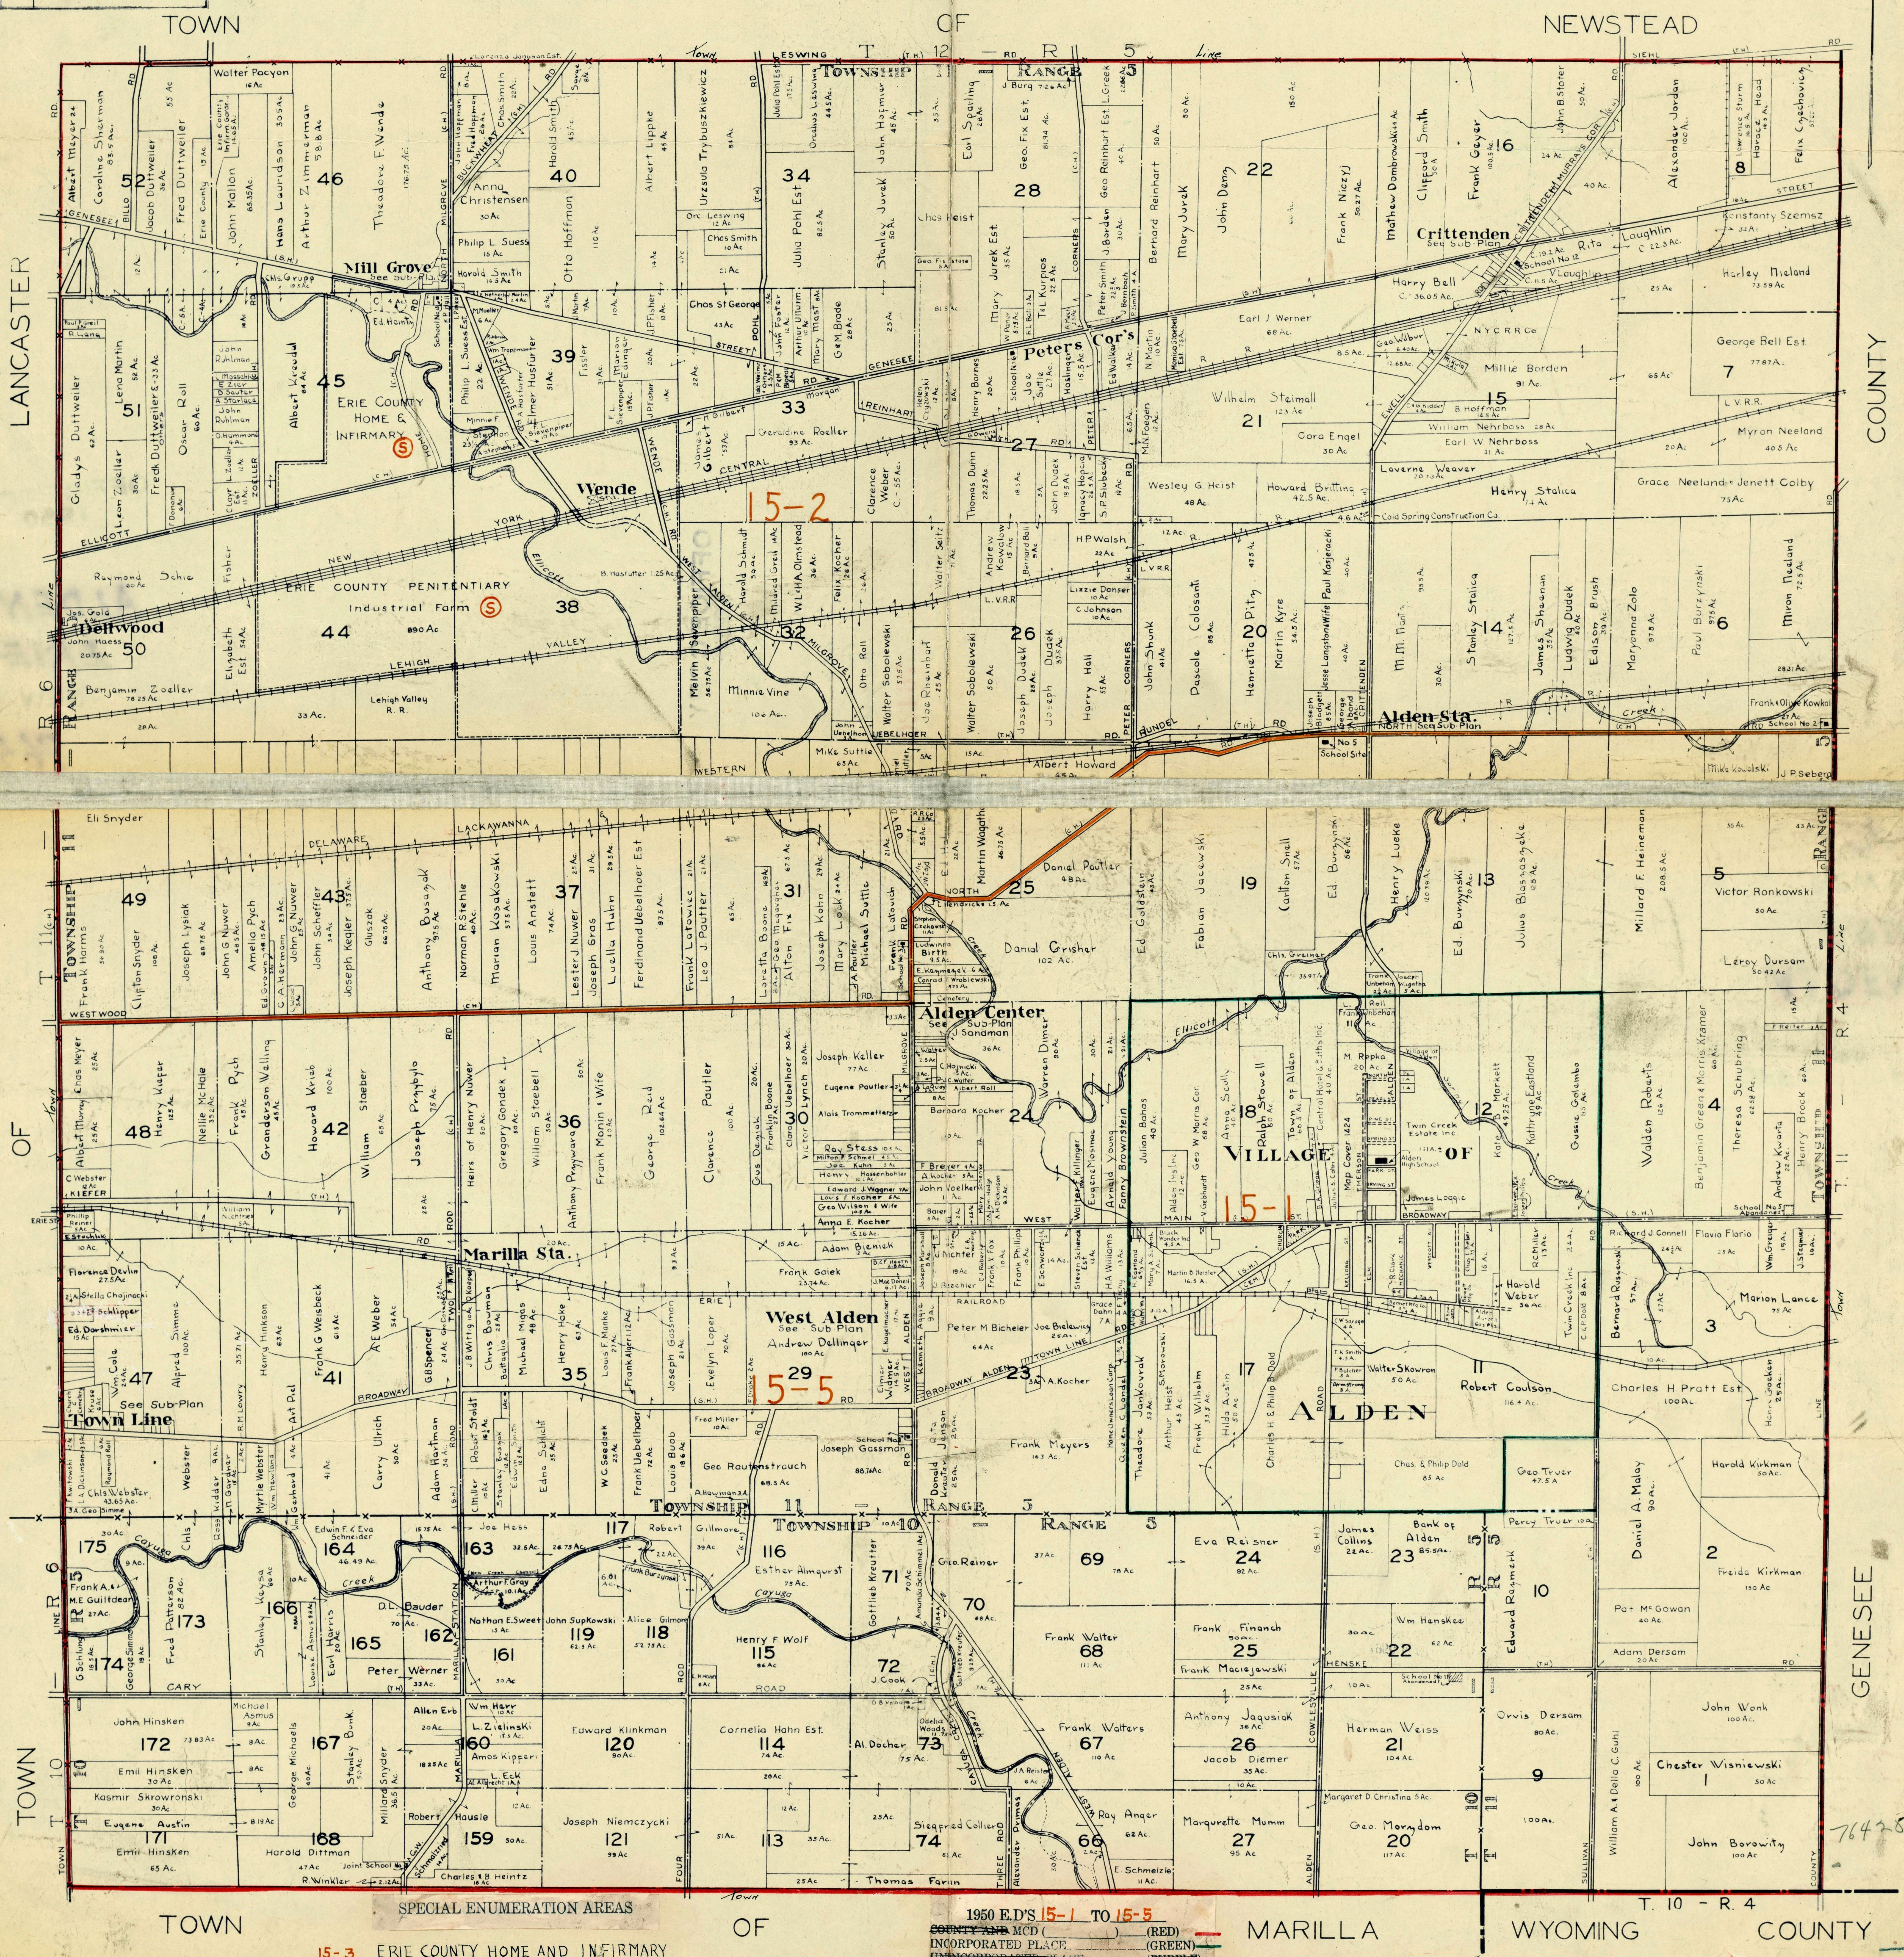

CORRECTED TO JUNE 1, 1947

SPECIAL ENUMERATION AREAS

15-3 ERIE COUNTY HOME AND INFIRMARY
15-4 ERIE COUNTY PENITENTIARY

1950 E.D'S 15-1 TO 15-5
~~COUNTY AND~~ MCD (________)____(RED)
INCORPORATED PLACE________(GREEN)
~~UNINCORPORATED PLACE~~________(PURPLE)
ENUMERATION ~~DISTRICT~~________(ORANGE)

76420

76420

PARTLY WITHIN BUFFALO URBANIZED AREA –

OFFICE COPY 1950

1950 OFFICE MAP

# MAP OF
# THE TOWN OF
# AMHERST
## ERIE COUNTY, N.Y.

Reproduced by
ERIE COUNTY PLANNING BOARD
1948

76429

Note: This map is compiled from deeds recorded in the Erie County Clerks Office, surveys and other available data.

SPECIAL ENUMERATION AREAS

15-25 CONVENT OF SISTERS OF ST FRANCIS OF PENANCE AND CHRISTIAN CHARITY (SACRED HEART ACADEMY)

15-27 METHODIST HOME FOR CHILDREN

15-29 ST MARY OF THE ANGELS MOTHERHOUSE AND NOVITIATE OF SISTERS OF THE THIRD ORDER OF ST FRANCIS INCLUDING HOME FOR AGED

1950 E.D'S 15-6 TO 15-36

~~COUNTY AND~~ MCD ........ (RED)

INCORPORATED PLACE ........ (GREEN)

~~UNINCORPORATED PLACE~~ ........ ~~(PURPLE)~~

ENUMERATION DISTRICT ........ (ORANGE)

CENSUS TRACT ........ (BROWN)

URBANIZED AREA ........ (YELLOW)

This map has been reproduced by the Niagara Frontier Planning Board, from the map compiled by the Town of Amherst's W.P.A. Mapping Project.

COPYRIGHT 1937 NIAGARA FRONTIER PLANNING BOARD

OFFICE COPY 1950

1950 OFFICE MAP

# MAP OF
# THE TOWN OF
# AURORA
## ERIE COUNTY, N.Y.

Compiled by

**ERIE COUNTY PLANNING BOARD**

1948

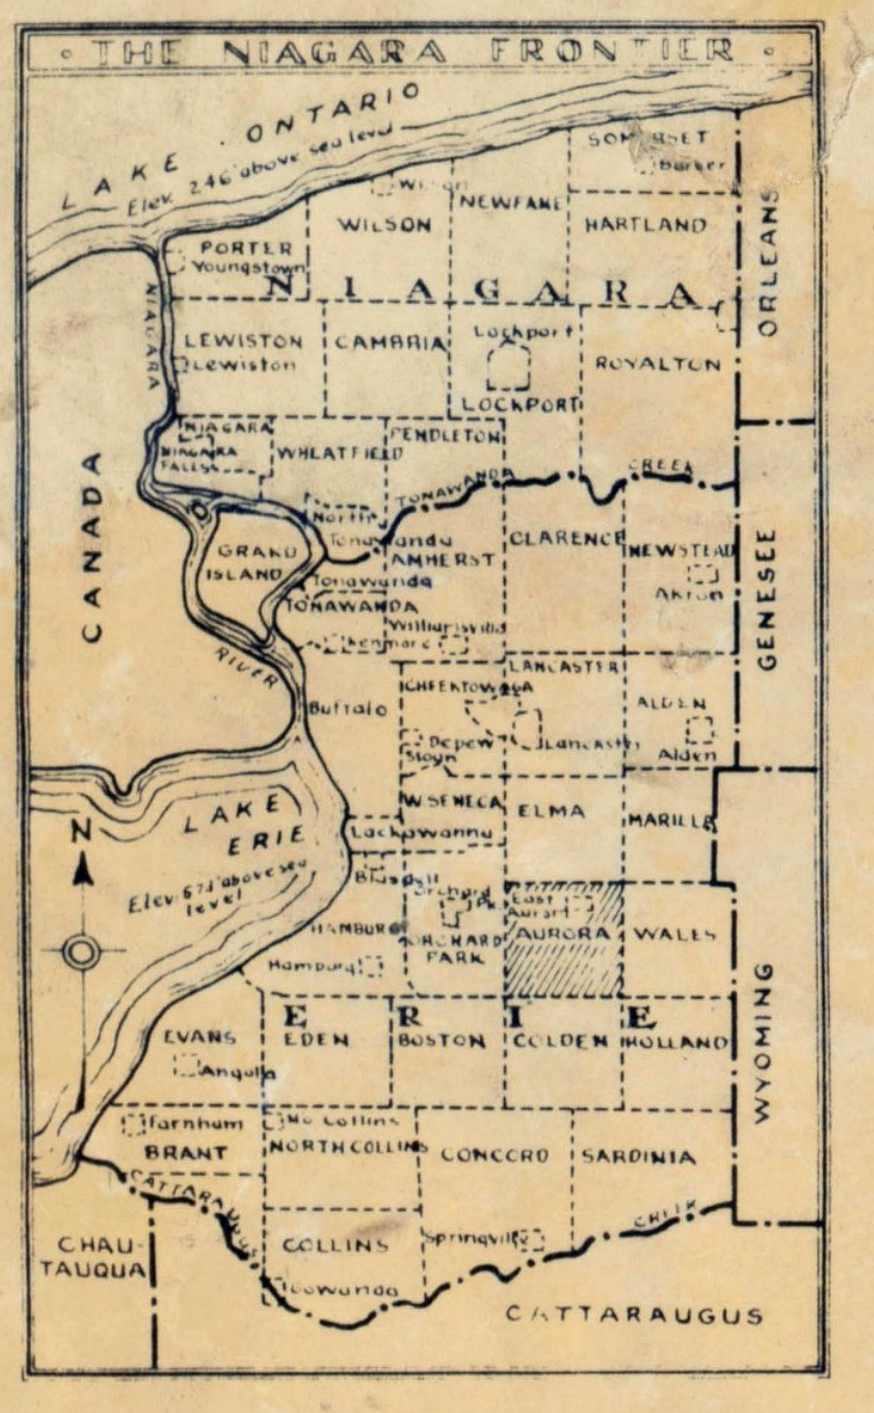

THE NIAGARA FRONTIER

Note: This map is compiled from deeds recorded in the Erie County Clerks Office Lots of less than one acre are not shown.

LEGEND

| | |
|---|---|
| TOWNSHIP & RANGE LINE | |
| CITY & VILLAGE LINE | |
| FARM GREAT LOT LINE | |
| PROPERTY LINE | |
| STATE HIGHWAY | CENTER (S.H.) ST |
| COUNTY HIGHWAY | GROVER (C.H.) RD |
| TOWN HIGHWAY | BAILEY (T.H.) RD |
| RAILROADS | |
| STREAMS | |
| PARKS | |

SCALE
Feet
1000 0 1000 2000 3000 4000 5000
Miles

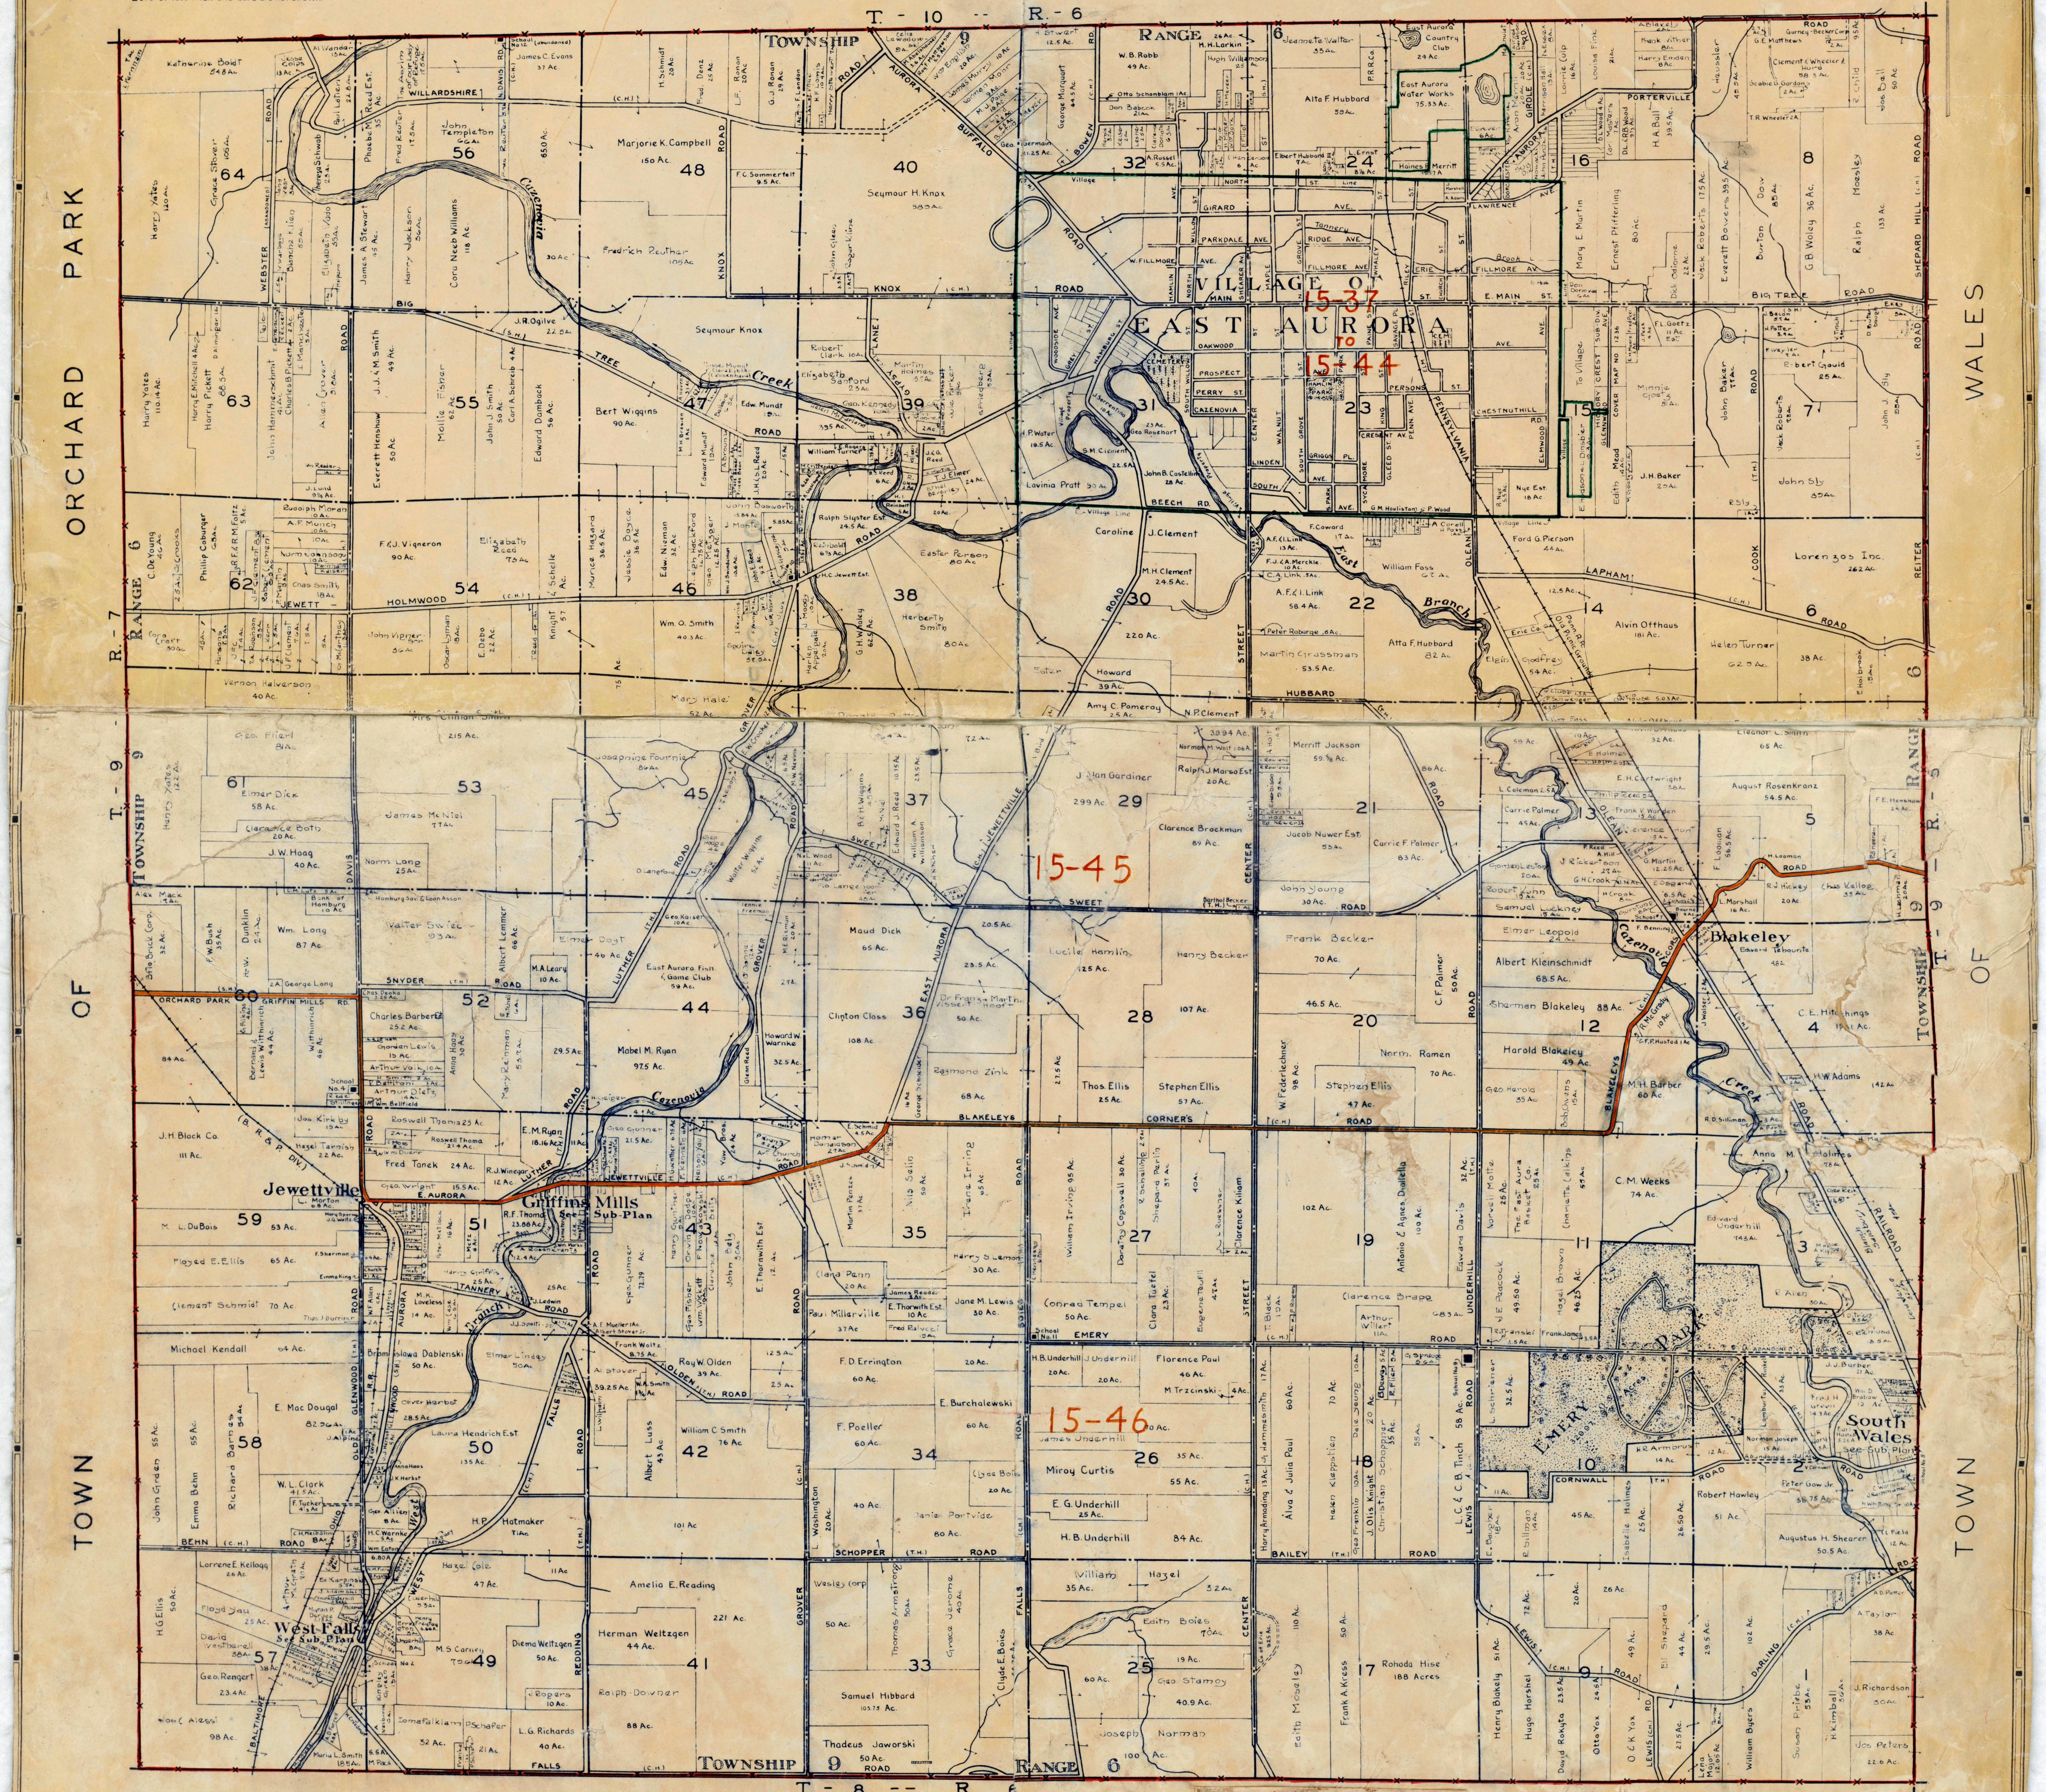

1950 E.D'S 15-37 TO 15-46
~~COUNTY AND~~ MCD (          )——(RED)
INCORPORATED PLACE——(GREEN)
~~UNINCORPORATED PLACE~~——(~~PURPLE~~)
ENUMERATION DISTRICT——(ORANGE)

76431

Corrected Through Jan. 1948

ENTIRELY WITHIN BUFFALO URBANIZED AREA

1950 OFFICE MAP

## SPECIAL ENUMERATION AREAS

| | |
|---|---|
| 65-44 | MOTHERHOUSE OF THE SISTERS OF MERCY INCLUDING MOUNT MERCY ACADEMY |
| 65-107 | BUFFALO HOTEL |
| 65-118 | U. S. COAST GUARD BASE |
| 65-142 | 500 CLINTON ST. APARTMENTS |
| 65-161 | LAFAYETTE HOTEL |
| 65-267 | CONVENT OF SISTERS OF ST. FRANCIS OF PENANCE AND CHRISTIAN CHARITY |
| 65-272 | CONVENT OF THE SISTERS OF THE THIRD ORDER OF ST. FRANCIS INCLUDING ST. FRANCIS ASYLUM |
| 65-313 | MONASTERY OF THE DOMINICAN NUNS OF THE PERPETUAL ROSARY |
| 65-351 | MONASTERY OF SISTERS OF OUR LADY OF CHARITY OF REFUGE |
| 65-367 | ROSWELL PARK MEMORIAL INSTITUTE |
| 65-369 | ROOSEVELT APARTMENTS |
| 65-372 | CONVENT OF DAUGHTERS OF CHARITY OF ST. VINCENT DE PAUL INCLUDING ST. MARY'S INFANT ASYLUM AND MATERNITY HOSPITAL |
| 65-380 | MARKEEN HOTEL |
| 65-422 | CONVENT OF THE THIRD ORDER OF ST. FRANCIS INCLUDING GERMAN ROMAN CATHOLIC ORPHAN HOME |
| 65-492 | EDWARD J. MEYER MEMORIAL HOSPITAL |
| 65-548 | U. S. VETERAN'S ADMINISTRATION HOSPITAL |
| 65-617 | CONVENT OF SISTERS OF ST. JOSEPH INCLUDING ST. MARY'S SCHOOL FOR THE DEAF |
| 65-618 | U. S. MARINE HOSPITAL |
| 65-625 | MOTHERHOUSE OF SISTERS OF ST. JOSEPH INCLUDING MOUNT ST. JOSEPH ACADEMY AND SCHOOL |
| 65-719 | BUFFALO STATE HOSPITAL |
| 65-743 | PARK LANE APARTMENTS |
| 65-747 | WEST FERRY ST. APARTMENTS |
| 65-757 | STRATFORD ARMS HOTEL |
| 65-767 | CAMPANILE APARTMENTS |
| 65-775 | MISSIONARY SISTERS OF THE DIVINE CHILD |
| 65-781 | AMBASSADOR APARTMENTS |
| 65-782 | STUYVESANT HOTEL |
| 65-784 | SHERATON HOTEL |
| 65-789 | LENOX HOTEL |
| 65-800 | TUDOR ARMS HOTEL |
| 65-827 | CONVENT OF GREY NUNS OF THE SACRED HEART INCLUDING D'YOUVILLE COLLEGE |
| 65-868 | GRAYSTONE HOTEL |
| 65-869 | TOURAINE HOTEL |
| 65-871 | MILNER HOTEL |
| 65-872 | RICHFORD HOTEL |
| 65-874 | STATLER HOTEL |
| 65-876 | RYAN'S-NIAGARA HOTEL |
| 65-877 | WORTH HOTEL |

### LEGEND

| | |
|---|---|
| CITY LIMIT AND WARD LINE | GREEN |
| E. D. BOUNDARY AND NUMBER | ORANGE |
| TRACT BOUNDARY | ═ |
| TRACT NUMBER | ⑦ |
| SEPARATE E. D'S | Ⓢ |
| ALL E. D. NUMBERS PRECEDED BY | 65 |
| E. D.S 65-1 TO 65-880 | |
| CONGRESSIONAL DISTRICT LINES | BLUE |

CITY OF
# BUFFALO
ERIE CO., NEW YORK

SCALE

750 0 750 1500 2250 FT.

COMPILED FROM CITY ENGINEER'S MAP AND SANBORN VOLS. 027 THRU 034, 036 AND 037

CORPORATE LIMITS

COMPILED BY M. BESTUL APRIL 22, 1949

BUREAU OF THE CENSUS

DUPLICATE COPY OF ORIGINAL 1950 OFFICE MAP PREPARED BY A. N. BRIGHT
VERIFIED TO ORIGINAL 1950 OFFICE MAP AND E.D. DESCRIPTIONS BY D.E. CULBERTSON 4-6-51
COPY MADE MAR. 7, 1951

CHECKED TO SANBORN - JAS. GORDON - 4-29-49 TRACTS + BLOCKS NUMBERS - JAS. T. GORDON - 5-12-49 CHECKED TRACTS + BLOCK NUMBERS - W. H. GORDON - 5-31-49 VERIFIED - W. GEORGE - 7-15-49 INKED NUMBERS + TRACTS VERIFIED - W. GEORGE - 8-8-49 REVIEW - S. DONDERO - 8-8-49

101190

PARTLY WITHIN BUFFALO URBANIZED AREA

1950 OFFICE MAP

OFFICE COPY 1950

# MAP OF
# THE TOWN OF
# CHEEKTOWAGA
## ERIE COUNTY, N.Y.

Reproduced by

ERIE COUNTY PLANNING BOARD

1948

76425

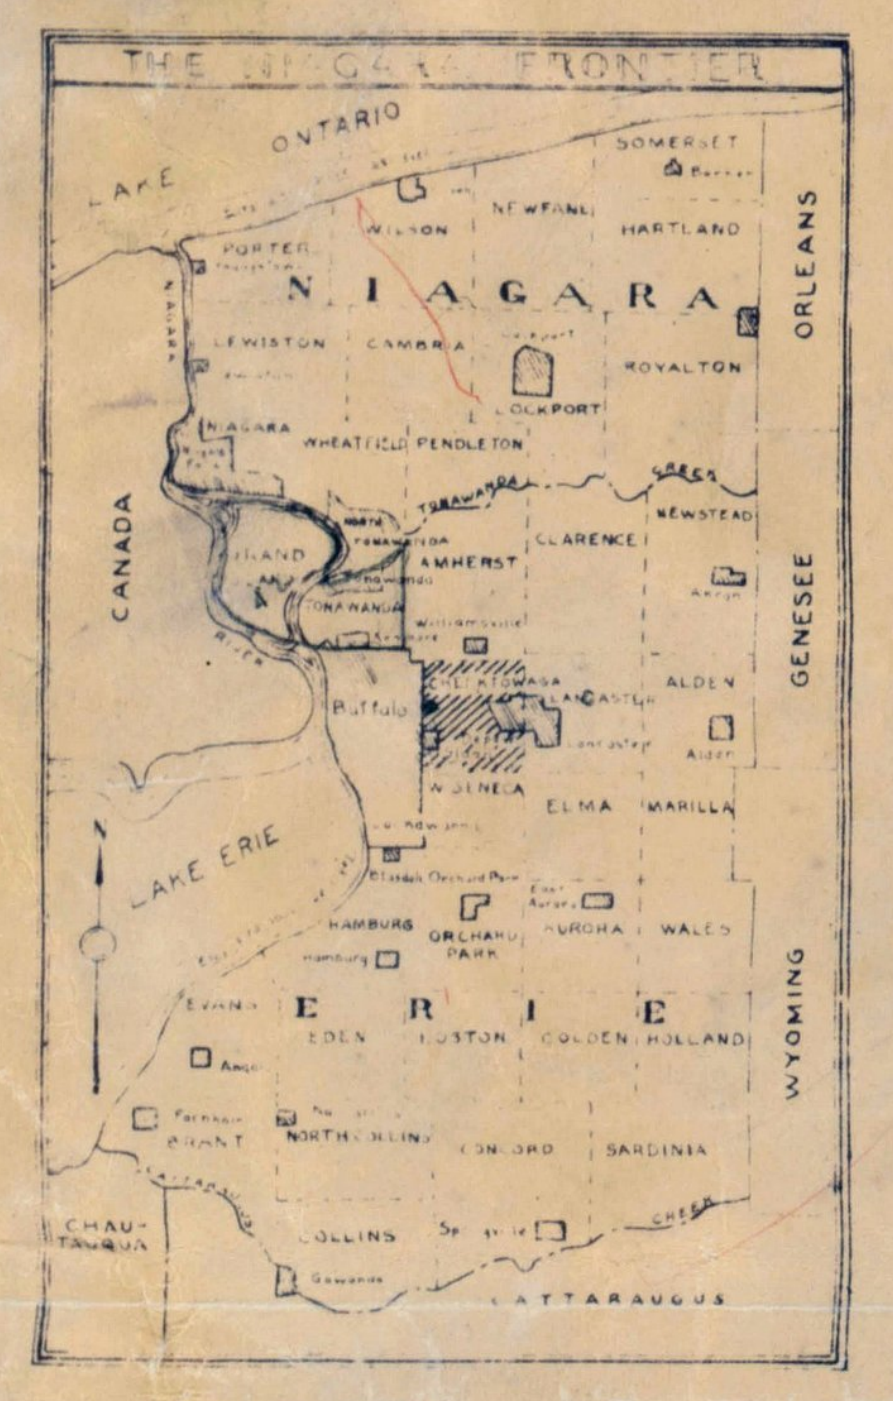

**LEGEND**

TOWNSHIP & RANGE LINE —x——x—
CITY & VILLAGE LINE
FARM & GREAT LOT LINE
PROPERTY LINE
STATE HIGHWAY GENESEE (S.H.) ROAD
COUNTY HIGHWAY CLEVELAND (C.H.) DRIVE
TOWN HIGHWAY HUTH (T.H.) ROAD
STREAMS

NOTE: This map is compiled from deeds recorded in the Erie County Clerks Office, surveys and other available data.

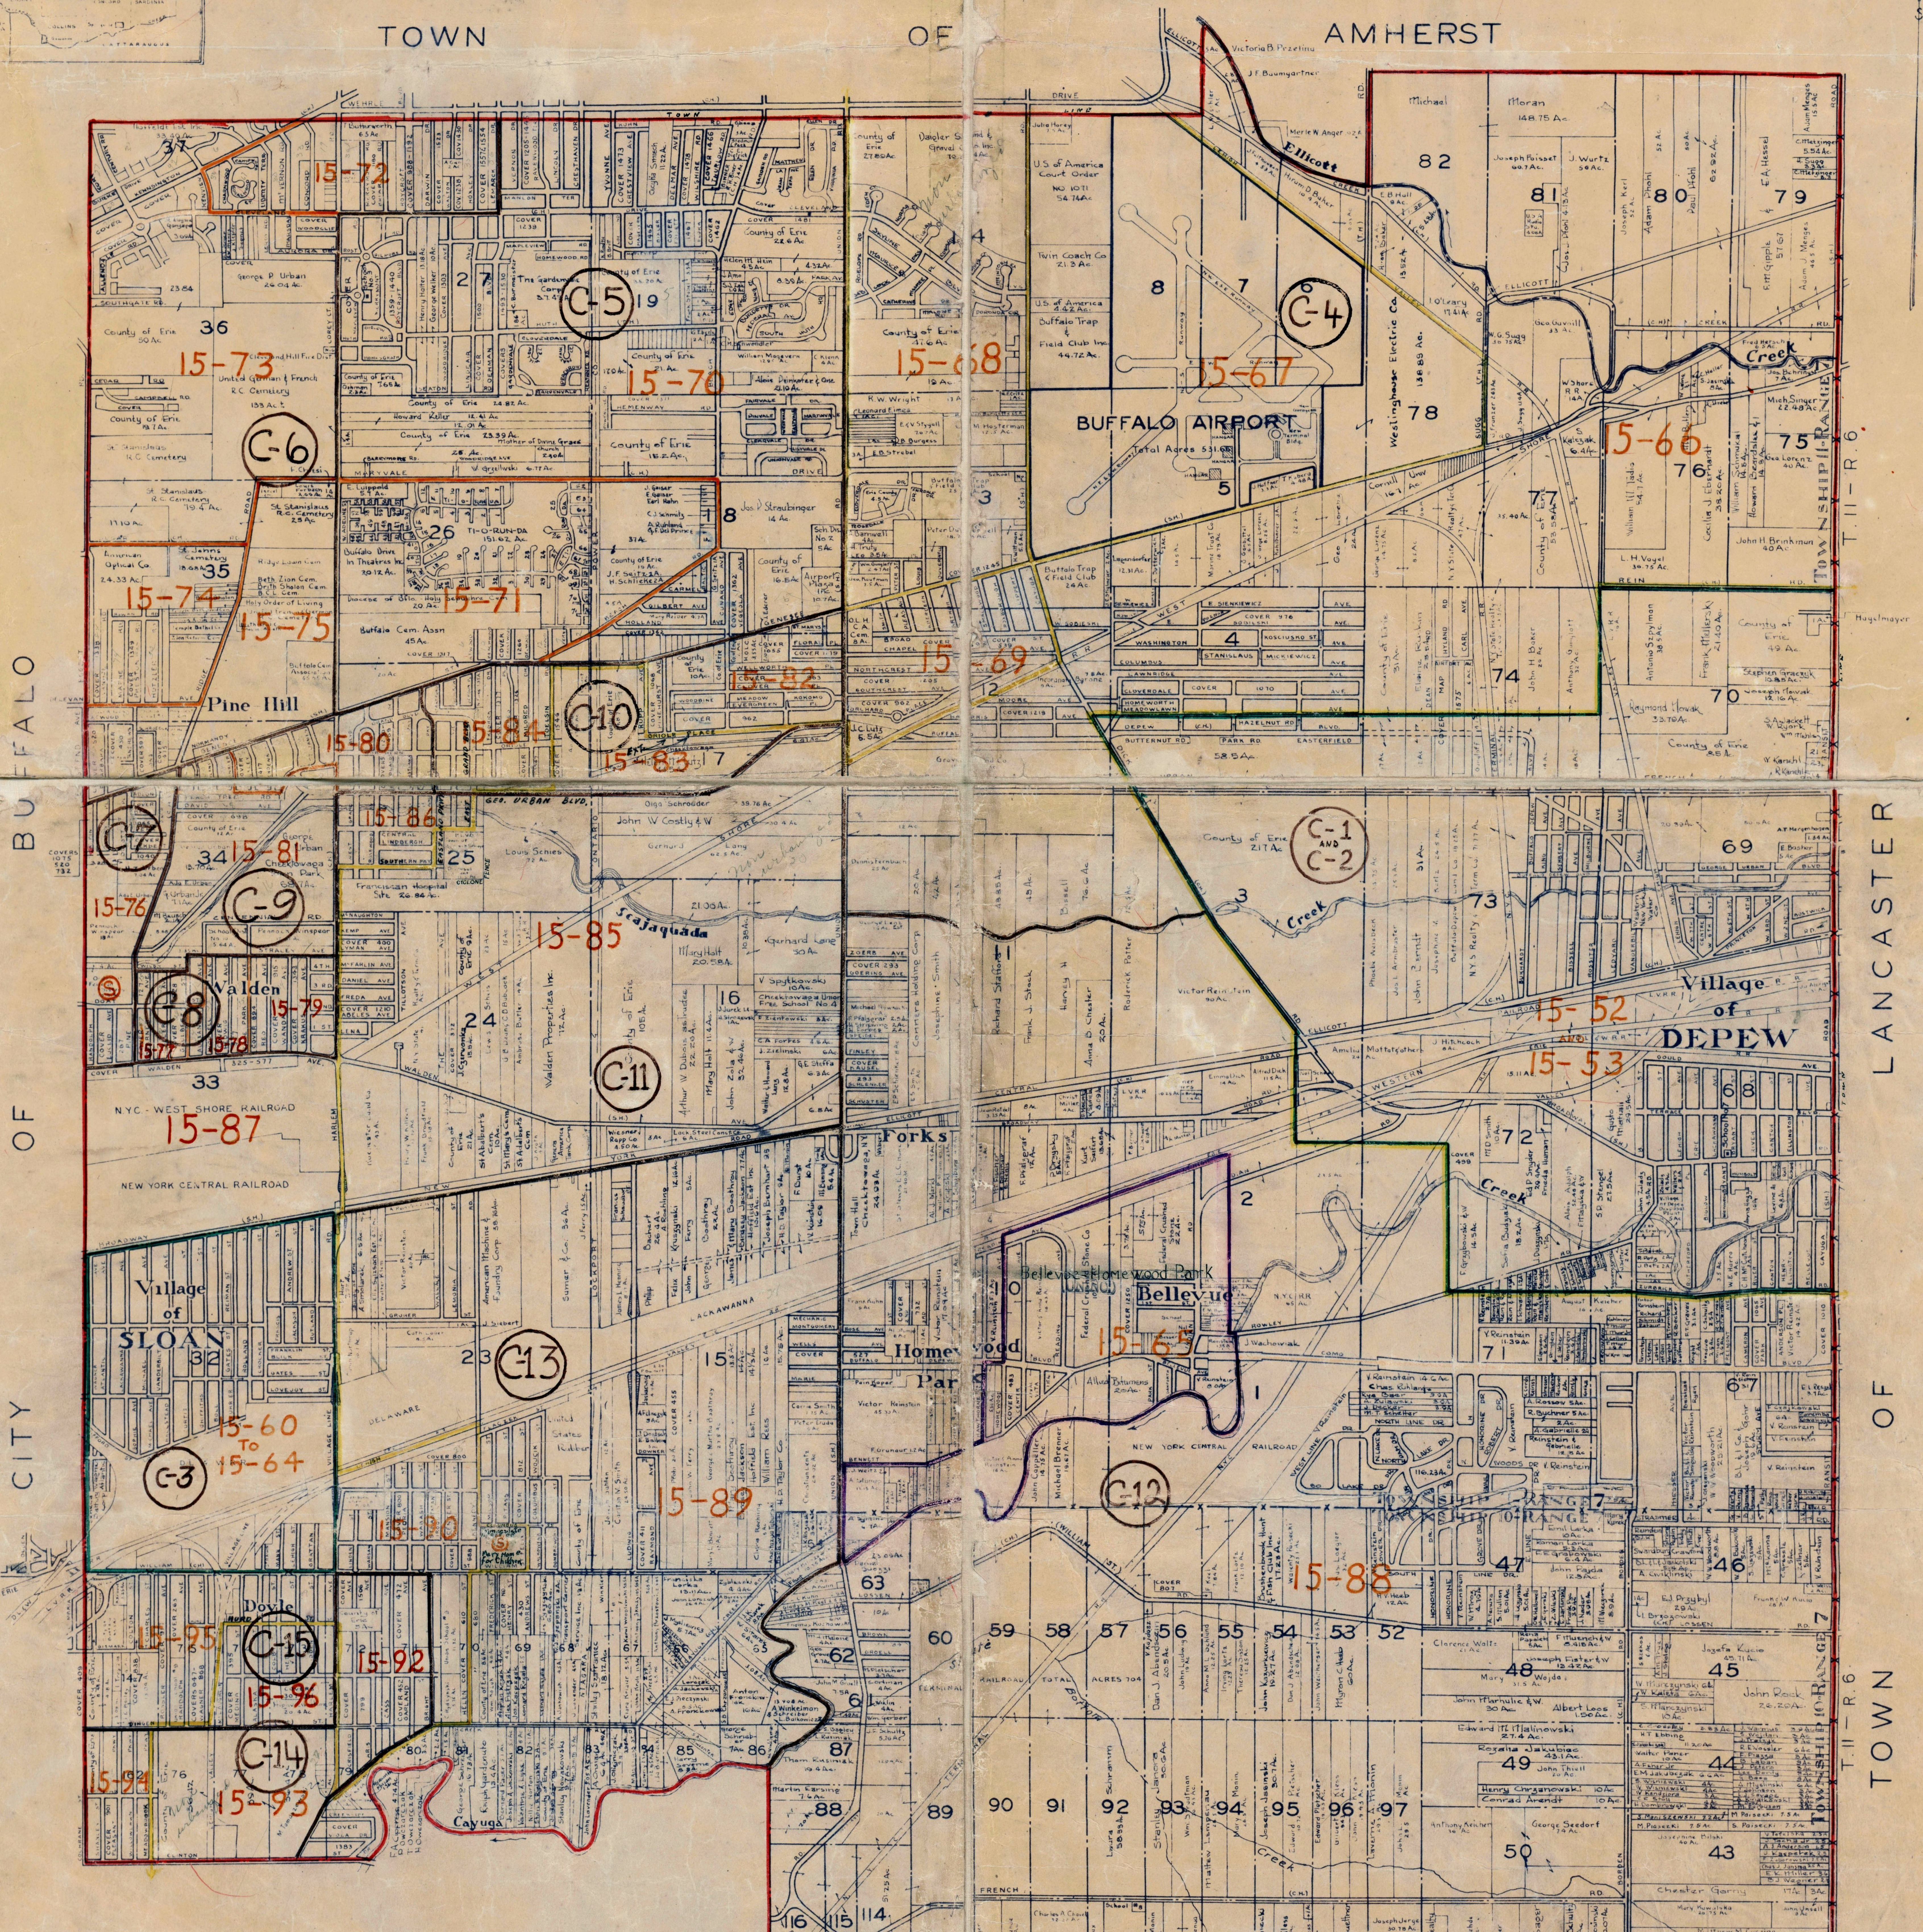

SCALE
Feet 0 1000 2000 3000 4000 5000
Miles 0 1/8 1/4 3/4 1 Mile

SPECIAL ENUMERATION AREAS

15-91 CONVENT OF FELICIAN SISTERS O.S.F
INCLUDING
IMMACULATE HEART OF MARY HOME FOR CHILDREN

15-254 PROVINCIAL MOTHERHOUSE OF FELICIAN SISTERS O.S.F
INCLUDING
IMMACULATE HEART OF MARY ACADEMY "VILLA MARIA"

1950 E.D'S 15-52 AND 15-53, 15-60 TO 15-96 AND 15-254

~~COUNTY AND MCD~~ (TOWN) ____ (RED)
INCORPORATED PLACE ____ (GREEN)
UNINCORPORATED PLACE ____ (PURPLE)
ENUMERATION DISTRICT ____ (ORANGE)
CENSUS TRACT ____ (BROWN)
URBANIZED AREA ____ (YELLOW)

NOTE: This map has been Reproduced through the courtesy of the Town of Cheektowaga from their official map.

CORRECTED TO JAN 1, 1948

Urbanized Area boundary
Reviewed and Approved
6/30/50 John K. Kirn
R. L. Wrigley

76425

1950 OFFICE MAP

# MAP OF
# THE TOWN OF
# CLARENCE
# ERIE COUNTY, N. Y.

Compiled by

**ERIE COUNTY PLANNING BOARD**

1948

76422

Note: This map is compiled from deeds recorded in the Erie County Clerks Office, surveys and other available data.

WORKS PROGRESS ADMINISTRATION
MAPPING PROJECT
SPONSORED BY
ERIE COUNTY BOARD OF SUPERVISORS

DUPLICATE COPY OF ORIGINAL 1950 OFFICE MAP PREPARED BY Muir

VERIFIED TO ORIGINAL 1950 OFFICE MAP & E.D. DESCRIPTIONS BY Henderson

DATE COPY WAS MADE 7-28-61

1950 E.D'S 15-97 TO 15-101

MCD (______________) ______(RED)

UNINCORPORATED PLACE ______(PURPLE)

76422

1950 OFFICE MAP

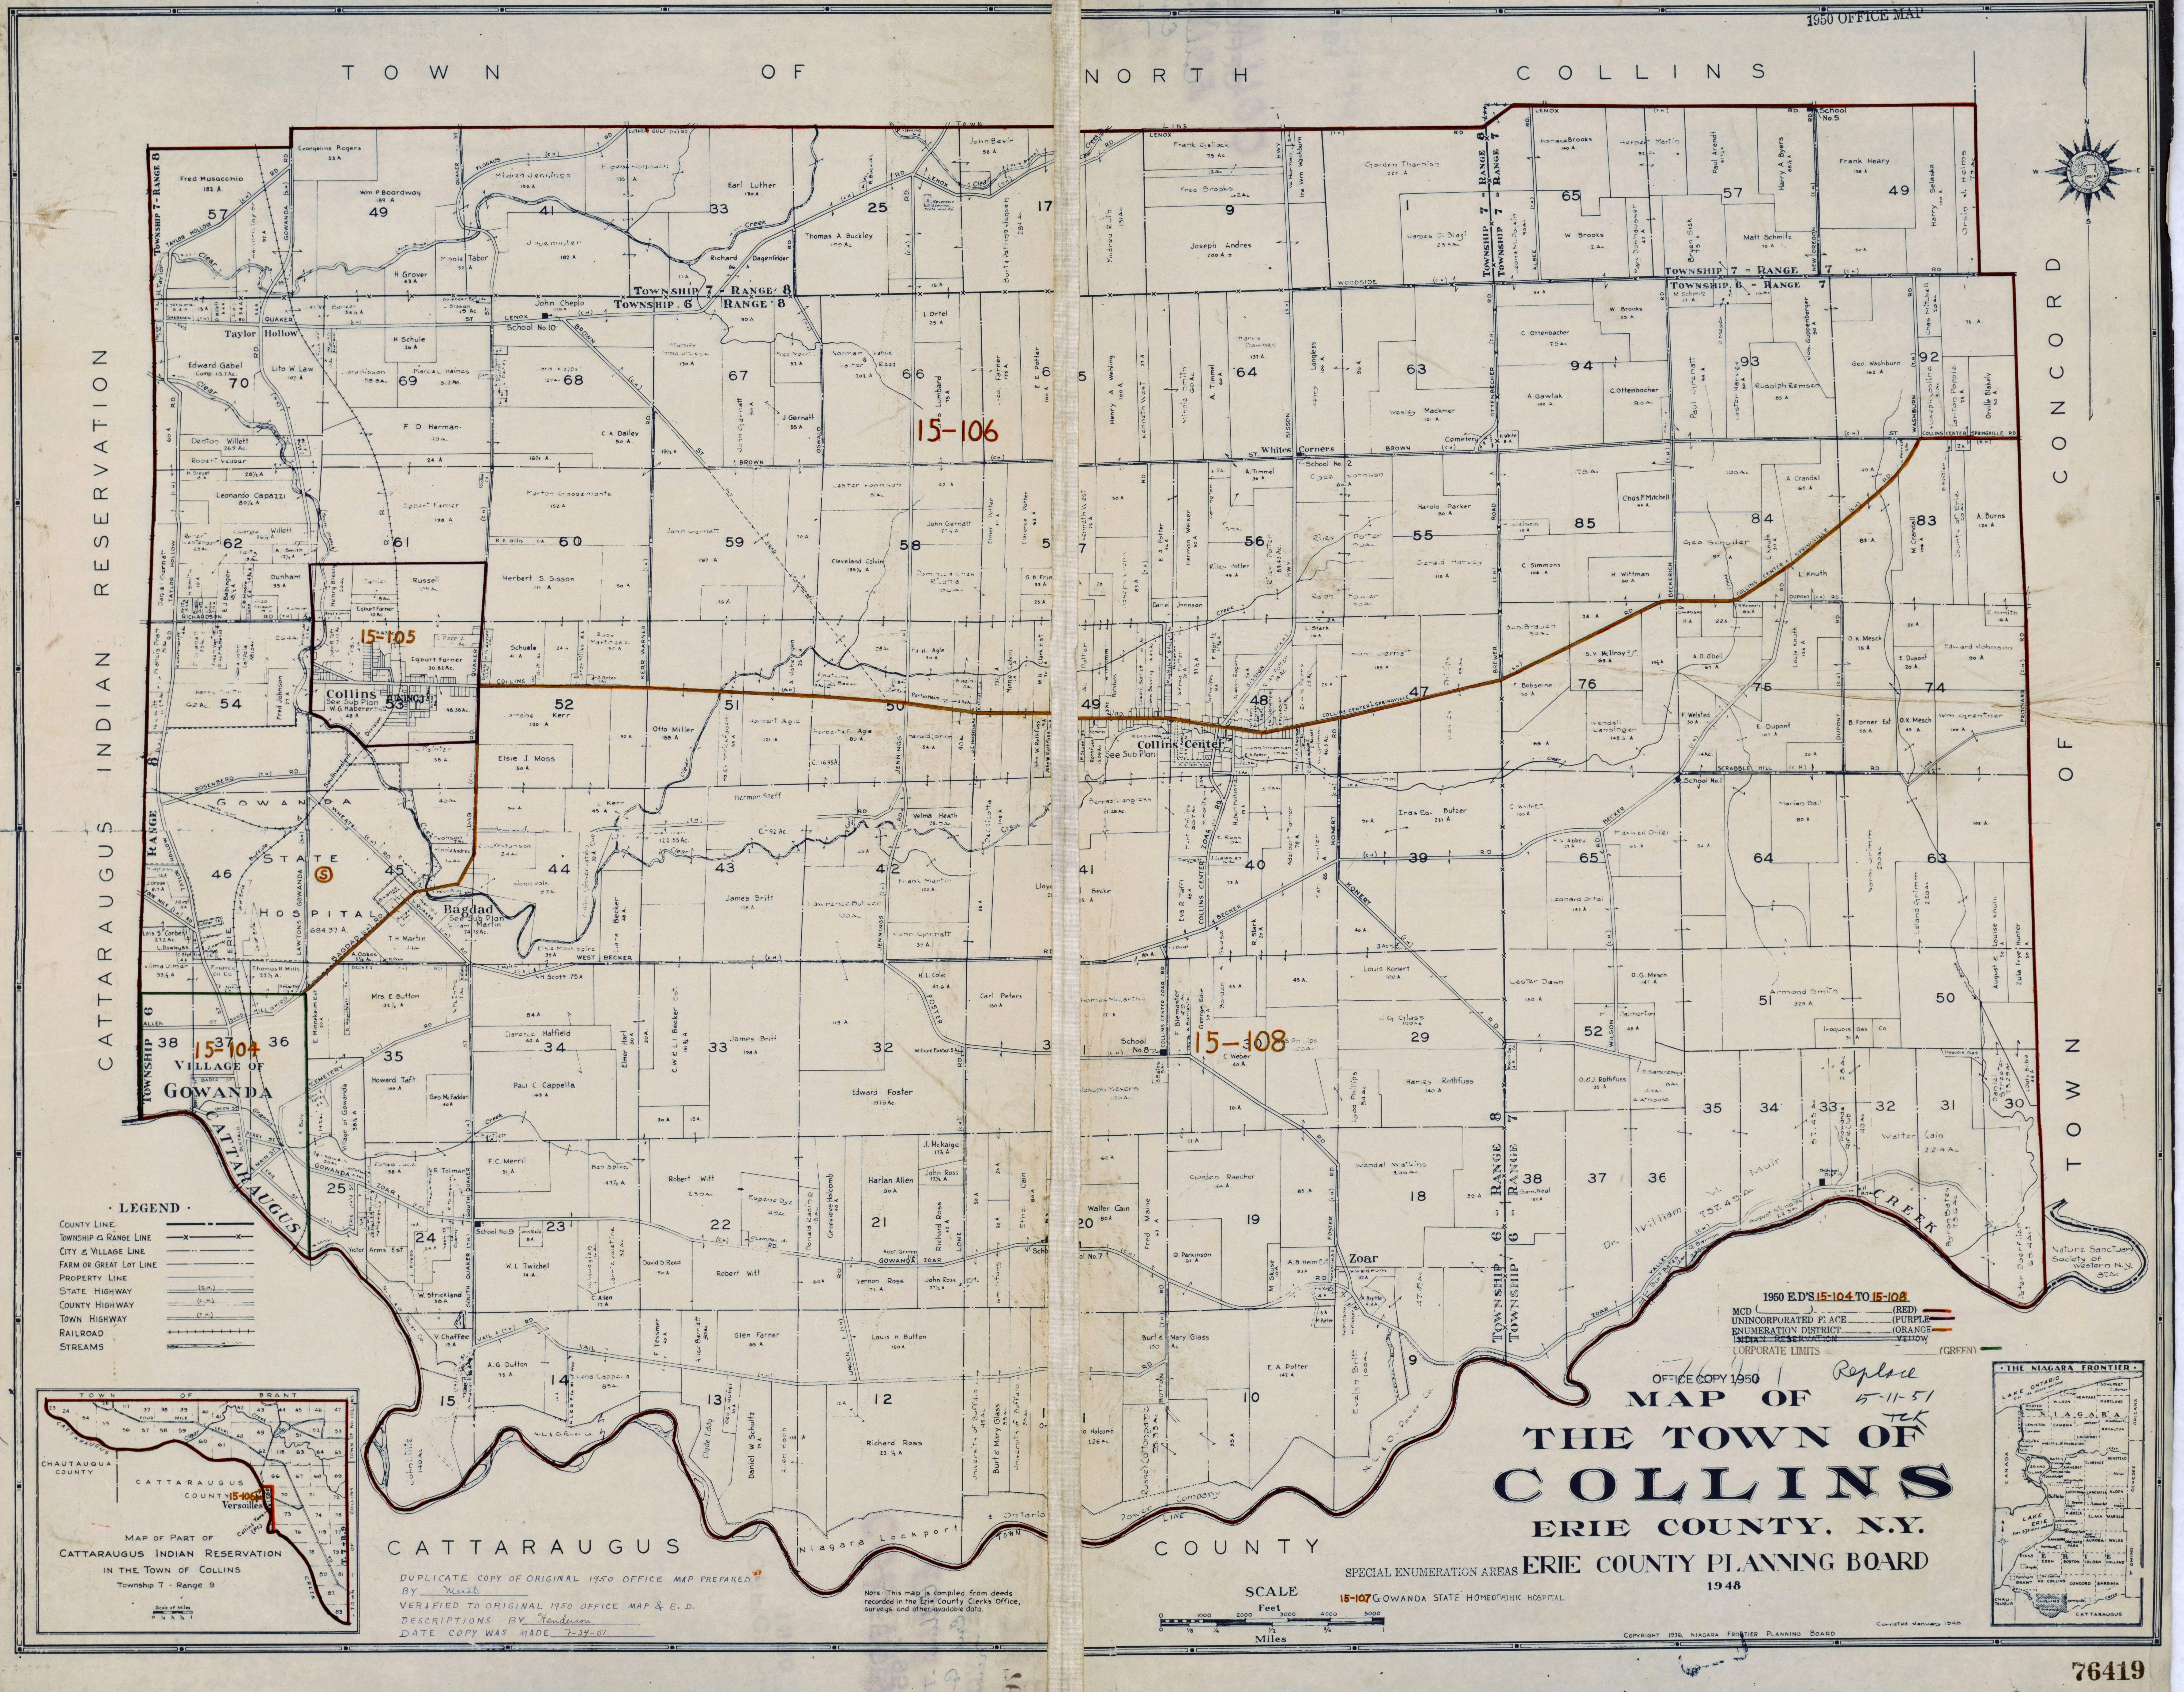

· LEGEND ·

| | |
|---|---|
| COUNTY LINE | ▬ - ▬ |
| TOWNSHIP & RANGE LINE | —×—×— |
| CITY & VILLAGE LINE | —··— |
| FARM OR GREAT LOT LINE | —·— |
| PROPERTY LINE | —— |
| STATE HIGHWAY | (S.H.) |
| COUNTY HIGHWAY | (C.H.) |
| TOWN HIGHWAY | (T.H.) |
| RAILROAD | ┼┼┼┼ |
| STREAMS | ～ |

MAP OF PART OF
CATTARAUGUS INDIAN RESERVATION
IN THE TOWN OF COLLINS
Township 7 - Range 9

DUPLICATE COPY OF ORIGINAL 1950 OFFICE MAP PREPARED
BY Marsh
VERIFIED TO ORIGINAL 1950 OFFICE MAP & E. D.
DESCRIPTIONS BY Henderson
DATE COPY WAS MADE 7-24-51

NOTE: This map is compiled from deeds recorded in the Erie County Clerk's Office, surveys and other available data.

1950 E.D'S 15-104 TO 15-108

MCD (_____) (RED)
UNINCORPORATED PLACE (PURPLE)
ENUMERATION DISTRICT (ORANGE)
~~INDIAN RESERVATION YELLOW~~
CORPORATE LIMITS (GREEN)

OFFICE COPY 1950

Replace 5-11-51 TCK

# MAP OF
# THE TOWN OF
# COLLINS
# ERIE COUNTY, N.Y.

SPECIAL ENUMERATION AREAS
15-107 GOWANDA STATE HOMEOPATHIC HOSPITAL

ERIE COUNTY PLANNING BOARD
1948

SCALE
Feet
0 1000 2000 3000 4000 5000
Miles
0 1/4 1/2 3/4 1

Correted January 1948

COPYRIGHT 1936, NIAGARA FRONTIER PLANNING BOARD

76419

1950 OFFICE MAP

OFFICE COPY 1950

# MAP OF THE TOWN OF CONCORD ERIE COUNTY, N.Y.

Compiled by
ERIE COUNTY PLANNING BOARD
194

Note. This map is compiled from deeds recorded in the Erie County Clerk's Office. Lots in the Village of Springville are not shown and Town lots of less than one acre are not shown.

## •• LEGEND ••

County Line
Township & Range Line
Power Line
City & Village Line
Farm or Great Lot Line
Property Line
State Highway (S H)
County Highway (C H)
Town Highway (T H)
Railroads
Streams
Parks

76417

SCALE
Feet
0 1000 2000 3000 4000 5000
0 1/8 1/4 1/2 3/4 1
Miles

LEGEND
Town Line ---------- Red
Village Limits ---------- Green

CORRECTED TO JAN 1 1948

19

76417

ENTIRELY WITHIN BUFFALO URBANIZED AREA

OFFICE COPY 1950

1950 OFFICE MAP

# VILLAGE OF DEPEW, NY

AREA: 5.137 SQ. MILES

73740

NEW YORK
Erie 30-15

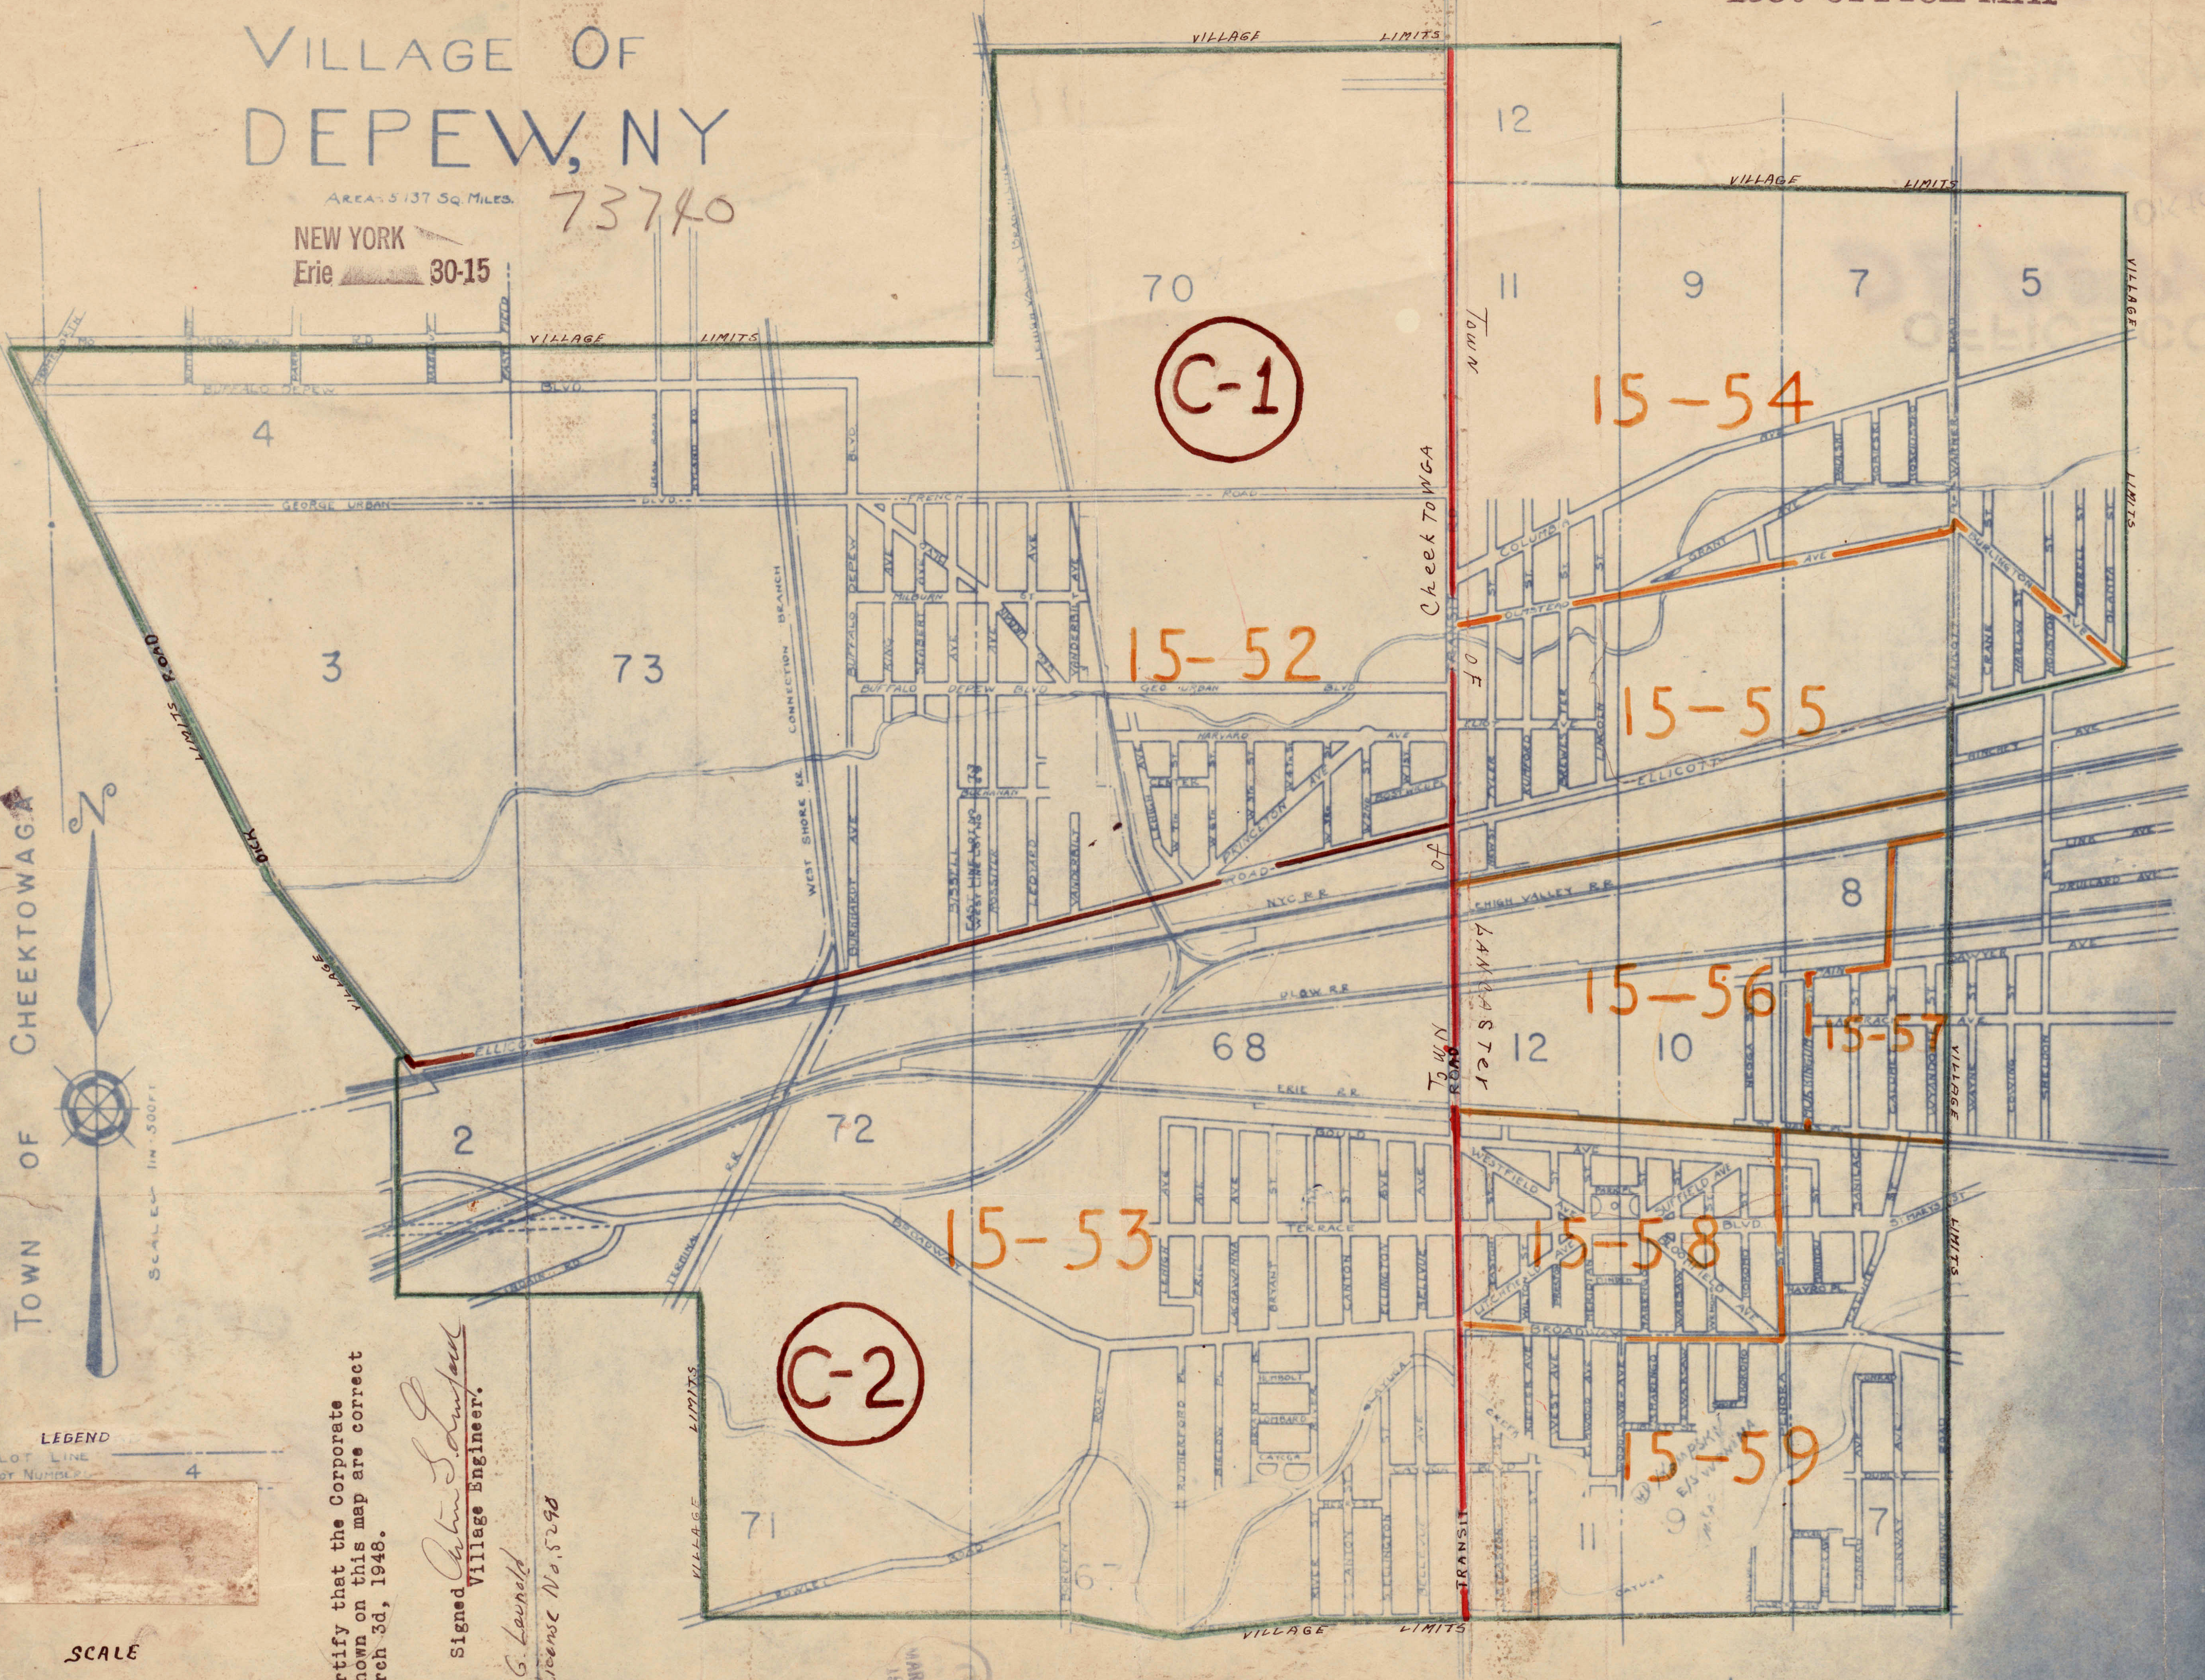

LEGEND
GREAT LOT LINE
GREAT LOT NUMBERS 4

SCALE
1000 0 1000 2000 FT.

I, Certify that the Corporate limits shown on this map are correct as of March 3d, 1948.

Signed Arthur G. Lounsbury
Village Engineer.

Arthur G. Lounsbury
State License No. 5298

MAR 30 1948

TOWN OF LANCASTER

1950 E.D'S 15-52 TO 15-59
CORPORATE LIMITS AND WARDS (GREEN) 🟩
ENUMERATION DISTRICT (ORANGE) 🟧
CENSUS TRACT C-1 (BROWN) 🟫
TOWN LINE (RED) 🟥

73740

1950 OFFICE MAP

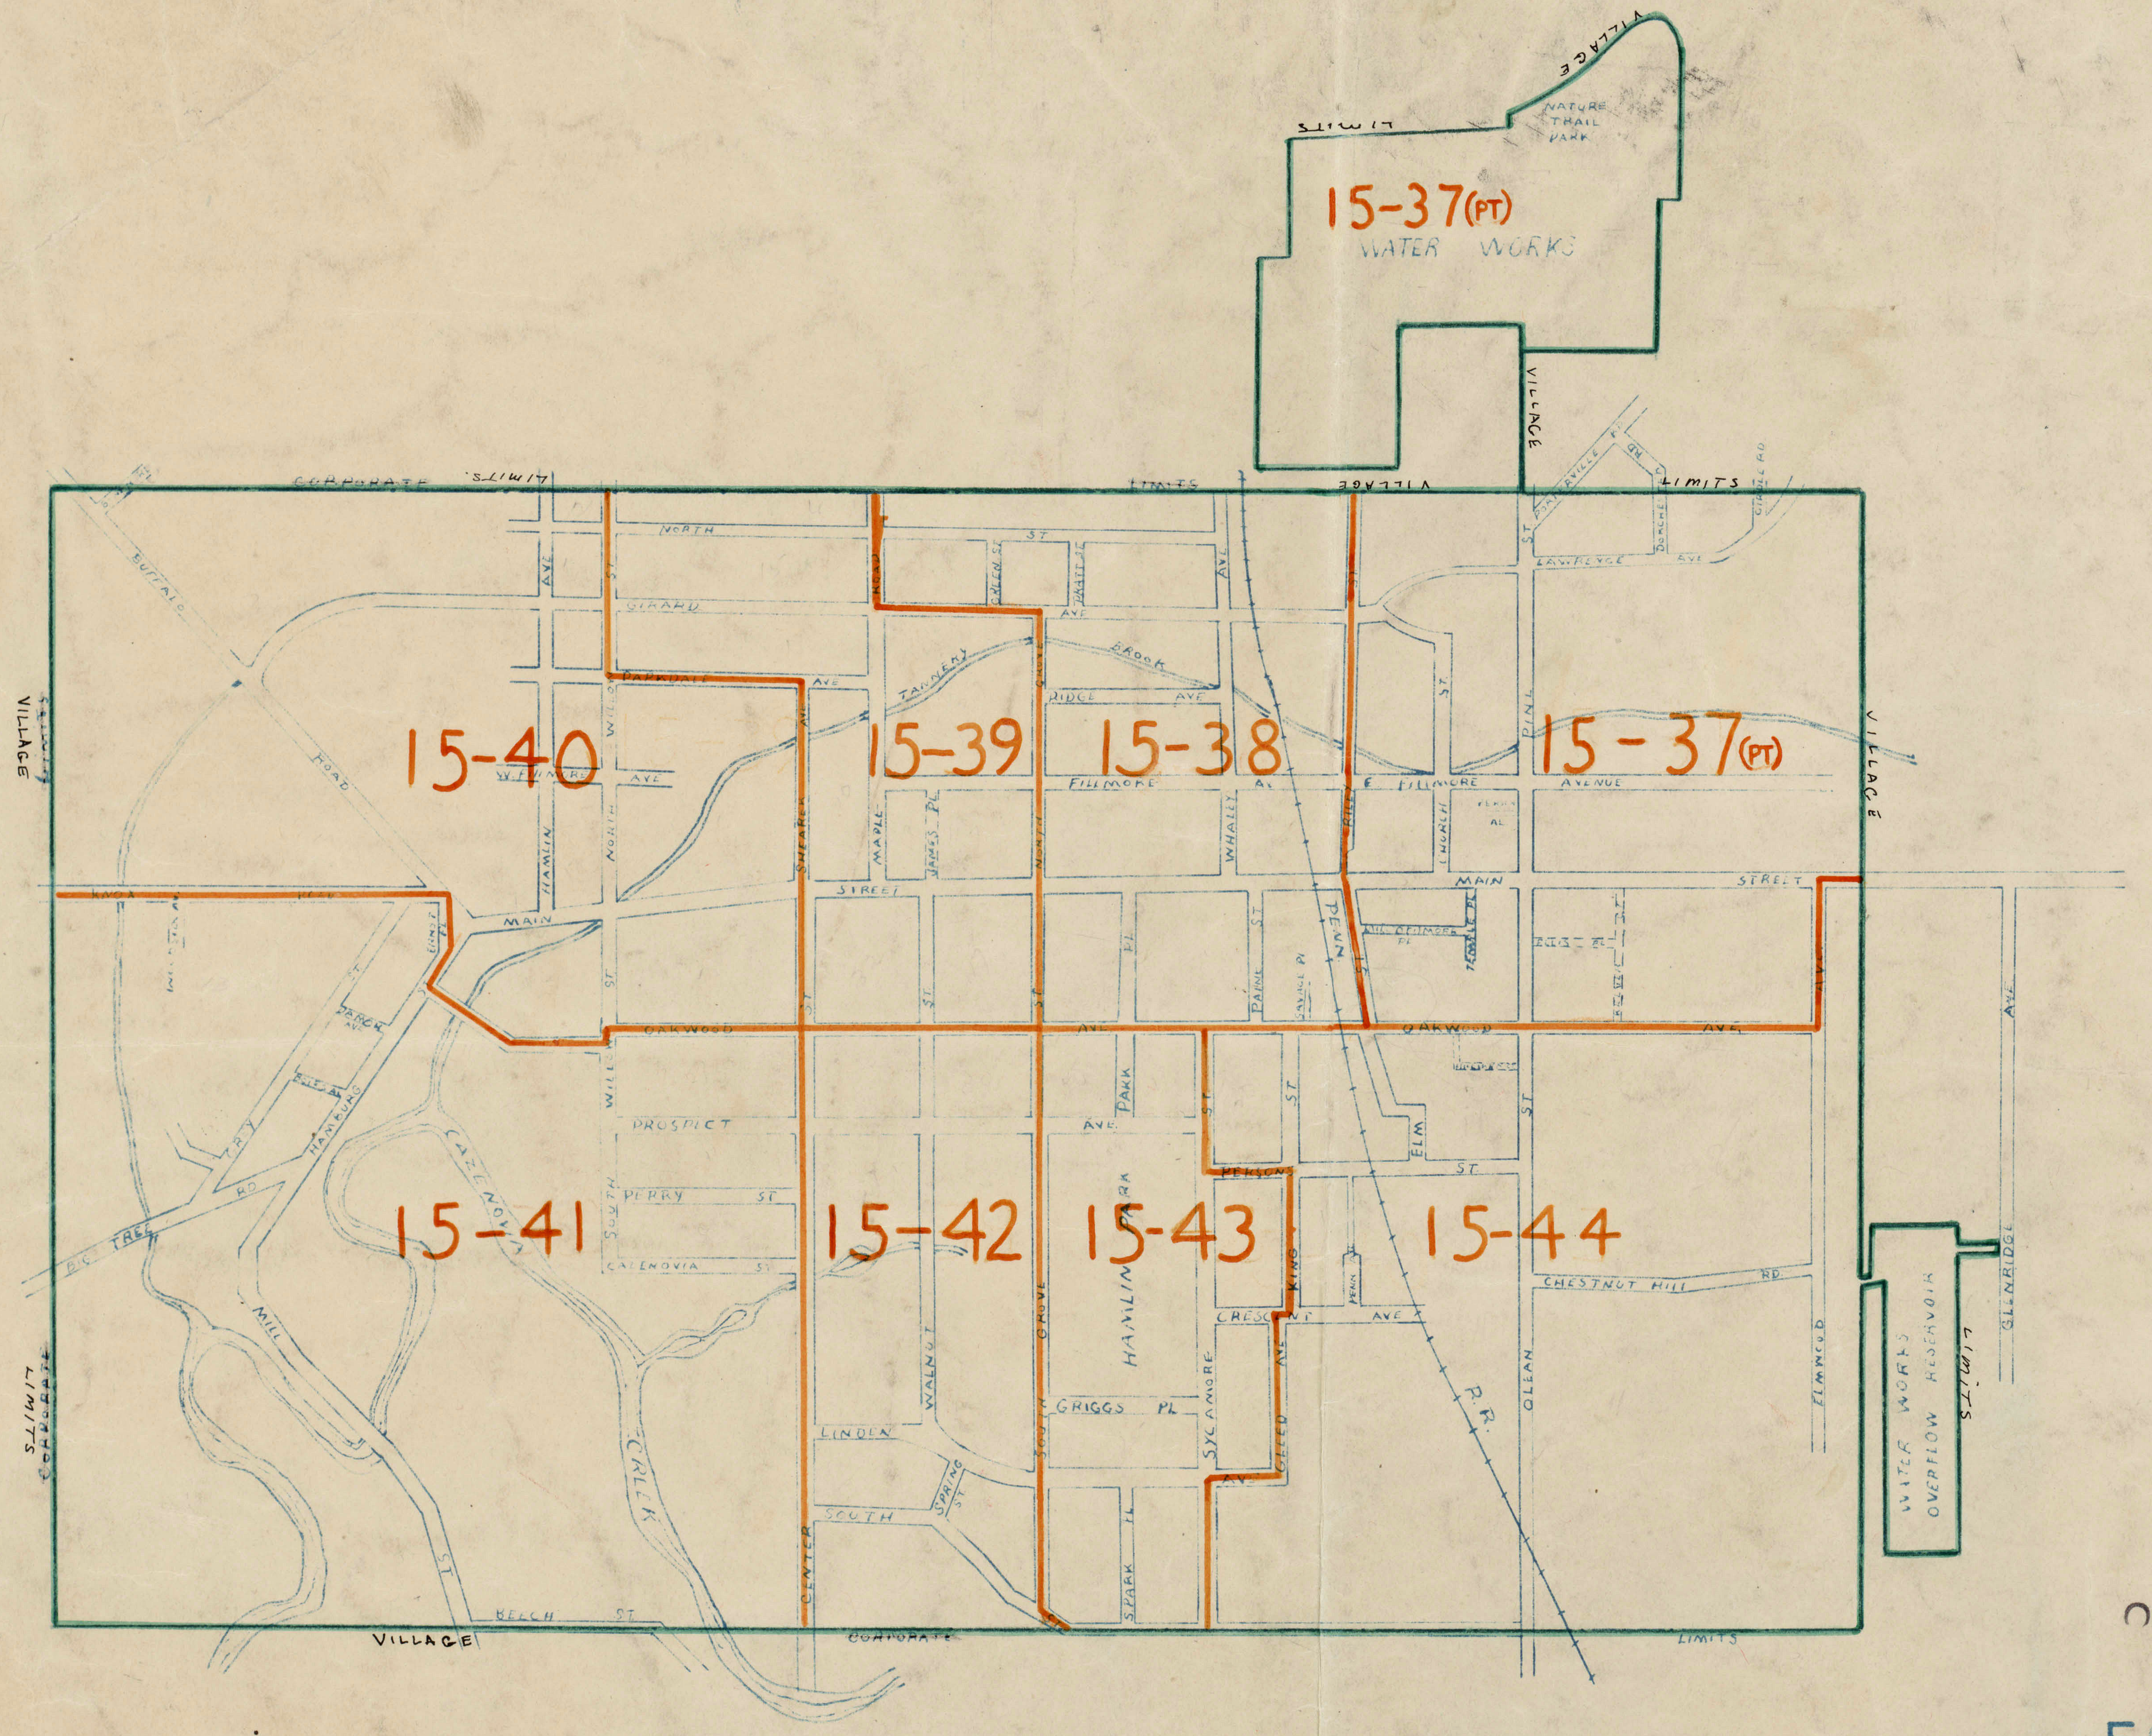

OFFICE COPY 1950

VILLAGE OF
EAST AURORA
ERIE CO. N.Y.

SCALE
700 0 700 1400 FT

COMPILED FROM MAP FILE NO.73700

——— - ——— - CORPORATE LIMITS

LEGEND

1950 E.D'S 15-37 TO 15
CORPORATE LIMITS ~~AND WARDS~~ ______ EN)
ENUMERATION DISTRICT ______ (ORANGE)

COMPILED BY R.E.MOORE 8-18-48

BUREAU OF THE CENSUS

92089

**1950 OFFICE MAP**

SEE DETAILED MAPS FOR:

- AKRON VILLAGE
- ALDEN VILLAGE
- ALDEN TOWN
- AMHERST TOWN
- ANGOLA VILLAGE
- ANGOLA-ON-THE-LAKE (UNINC)
- AURORA TOWN
- BELLEVUE-HOMEWOOD PARK (UNINC)
- BLASDELL VILLAGE
- BOSTON TOWN
- BRANT TOWN
- CHEEKTOWAGA TOWN
- CLARENCE (UNINC)
- CLARENCE CENTER (UNINC)
- CLARENCE TOWN
- COLDEN TOWN
- COLLINS (UNINC)
- COLLINS TOWN
- CONCORD TOWN
- DEPEW VILLAGE
- EAST AURORA VILLAGE
- EDEN (UNINC)
- EDEN TOWN
- ELMA TOWN
- EVANS TOWN
- FARNHAM VILLAGE
- GRAND ISLAND TOWN
- GOWANDA VILLAGE
- HAMBURG VILLAGE
- HAMBURG TOWN
- HIGHLAND-ON-THE-LAKE (UNINC)
- HOLLAND (UNINC)
- HOLLAND TOWN
- KENMORE VILLAGE
- LACKAWANNA CITY
- LAKE ERIE BEACH (UNINC)
- LANCASTER VILLAGE
- LANCASTER TOWN
- MARILLA TOWN
- NEWSTEAD TOWN
- NORTH COLLINS VILLAGE
- NORTH COLLINS TOWN
- ORCHARD PARK VILLAGE
- ORCHARD PARK TOWN
- SANDY BEACH (UNINC)
- SARDINIA TOWN
- SLOAN VILLAGE
- SPRINGVILLE VILLAGE
- TONAWANDA CITY
- TONAWANDA TOWN
- WALES TOWN
- WEST SENECA TOWN
- WILLIAMSVILLE VILLAGE

SPECIAL ENUMERATION AREAS

15-334 THOMAS INDIAN SCHOOL (IN CATTARAUGUS INDIAN RESERVATION)

1950 E.D'S 15-1 TO 15-337 AND 65-1 TO 65-880

| | |
|---|---|
| COUNTY AND MCD ( TOWN ) (RED) | 🟥 |
| INCORPORATED PLACE (GREEN) | 🟩 |
| ENUMERATION DISTRICT (ORANGE) | 🟧 |
| CONGRESSIONAL DISTRICT (BLUE) | 🟦 |

# ERIE COUNTY
## NEW YORK

PREPARED BY THE
N.Y. STATE DEPARTMENT OF PUBLIC WORKS
DIVISION OF HIGHWAYS
IN COOPERATION WITH THE
U.S. FEDERAL WORKS AGENCY
PUBLIC ROADS ADMINISTRATION
DATA OBTAINED FROM
STATEWIDE HIGHWAY PLANNING SURVEY

SCALE
1 0 1 2 MILES

1946
POLYCONIC PROJECTION

DUPLICATE COPY OF ORIGINAL 1950 OFFICE MAP
VERIFIED TO ORIGINAL 1950 OFFICE MAP &
DATE COPY WAS MADE 5-18-51

PREPARED BY C. B. Bailey
E.D. DESCRIPTIONS BY Henderson

LEGEND SHOWN ON SHEET 2
ENLARGEMENTS SHOWN ON SUPPLEMENTAL SHEET A

SHEET 1 OF 3 MAP SHEETS AND 2 SUPPLEMENTAL SHEETS

ERIE COUNTY NEW YORK 15

ERIE CO. (1)

**ERIE COUNTY**
NEW YORK

SCALE
2 MILES

1946

STATE KEY MAP SHOWN ON SHEET 1
LEGEND SHOWN ON SHEET 2
ET ENLARGEMENTS SHOWN O SUPPLEMENTAL SHEET B
COMPACT ENLARGEMENTS SHOWN O SUPPLEMENTAL SHEET B

Duplicate copy of original 1950 office map prepared by C.B. Bailey
Verified to original 1950 office map and E.D. descriptions by Henderson
Date copy was made 5-18-51

SHEET 3 OF 3 MAP SHEETS AND 2 SUPPLEMENTAL SHEETS

ERIE CO (2)

1950 OFFICE MAP

DUPLICATE COPY OF ORIGINAL 1950 OFFICE MAP PREPARED BY C. B. Bailey
VERIFIED TO ORIGINAL 1950 OFFICE MAP & E.D. DESCRIPTIONS BY Henderson
DATE COPY WAS MADE 5-18-51

STATE KEY MAP SHOWN ON SHEET 1
LEGEND SHOWN ON SHEET 2
ENLARGEMENTS SHOWN ON SUPPLEMENTAL SHEET A

# ERIE COUNTY
## NEW YORK

SCALE

1 0 1 2 MILES

1946

SHEET 2 OF 3 MAP SHEETS AND 2 SUPPLEMENTAL SHEETS

# MAP OF
# THE TOWN OF
# EVANS
## ERIE COUNTY, N.Y.

Compiled by
ERIE COUNTY PLANNING BOARD
1948

76427

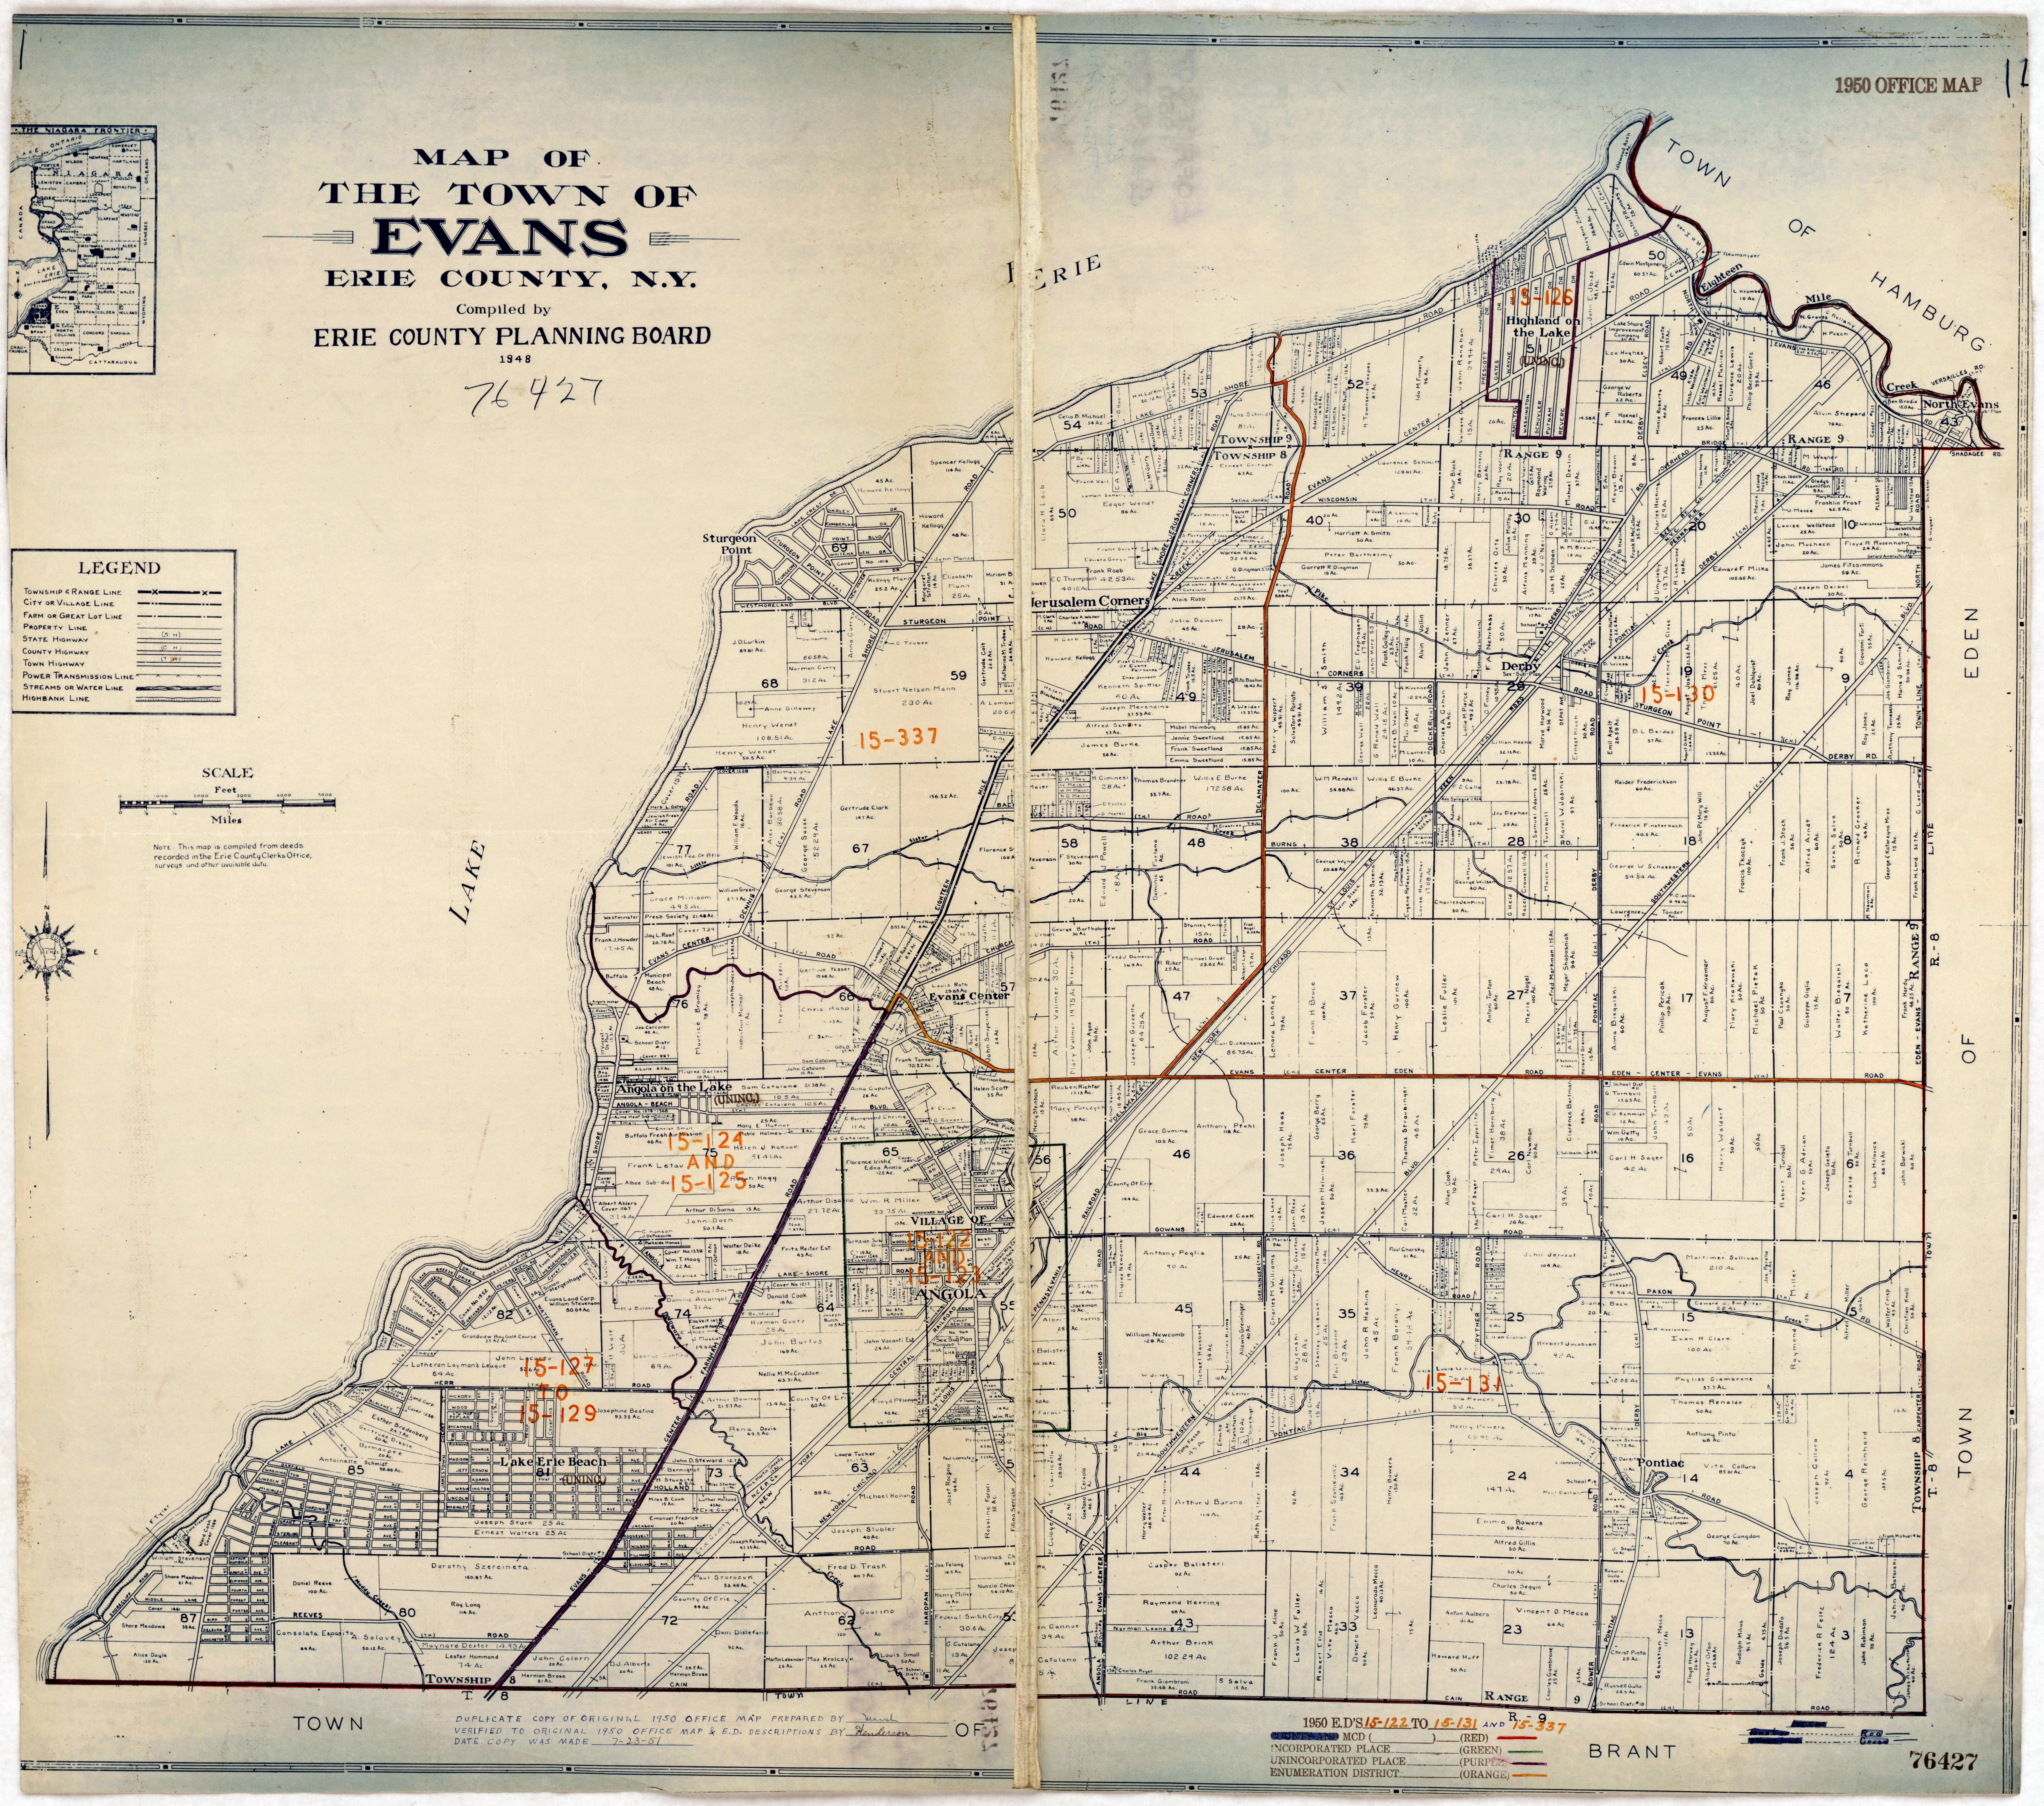

## LEGEND

| | |
|---|---|
| Township & Range Line | ━✕━━━✕━ |
| City or Village Line | ━‥━━━‥━ |
| Farm or Great Lot Line | ━·━━━·━ |
| Property Line | ─── |
| State Highway | (S H) |
| County Highway | (C H) |
| Town Highway | (T H) |
| Power Transmission Line | ‸ ‸ ‸ ‸ |
| Streams or Water Line | ≈≈≈ |
| Highbank Line | ┴┴┴┴ |

SCALE
Feet
0 1000 2000 3000 4000 5000
0 1/8 1/4 1/2 3/4 1
Miles

Note: This map is compiled from deeds recorded in the Erie County Clerks Office, surveys and other available data.

DUPLICATE COPY OF ORIGINAL 1950 OFFICE MAP PREPARED BY Marsh
VERIFIED TO ORIGINAL 1950 OFFICE MAP & E.D. DESCRIPTIONS BY Henderson
DATE COPY WAS MADE 7-23-51

1950 E.D'S 15-122 TO 15-131 AND 15-337
~~COUNTY AND~~ MCD (________)______(RED)
INCORPORATED PLACE______(GREEN)
UNINCORPORATED PLACE______(PURPLE)
ENUMERATION DISTRICT______(ORANGE)

76427

1950 OFFICE MAP

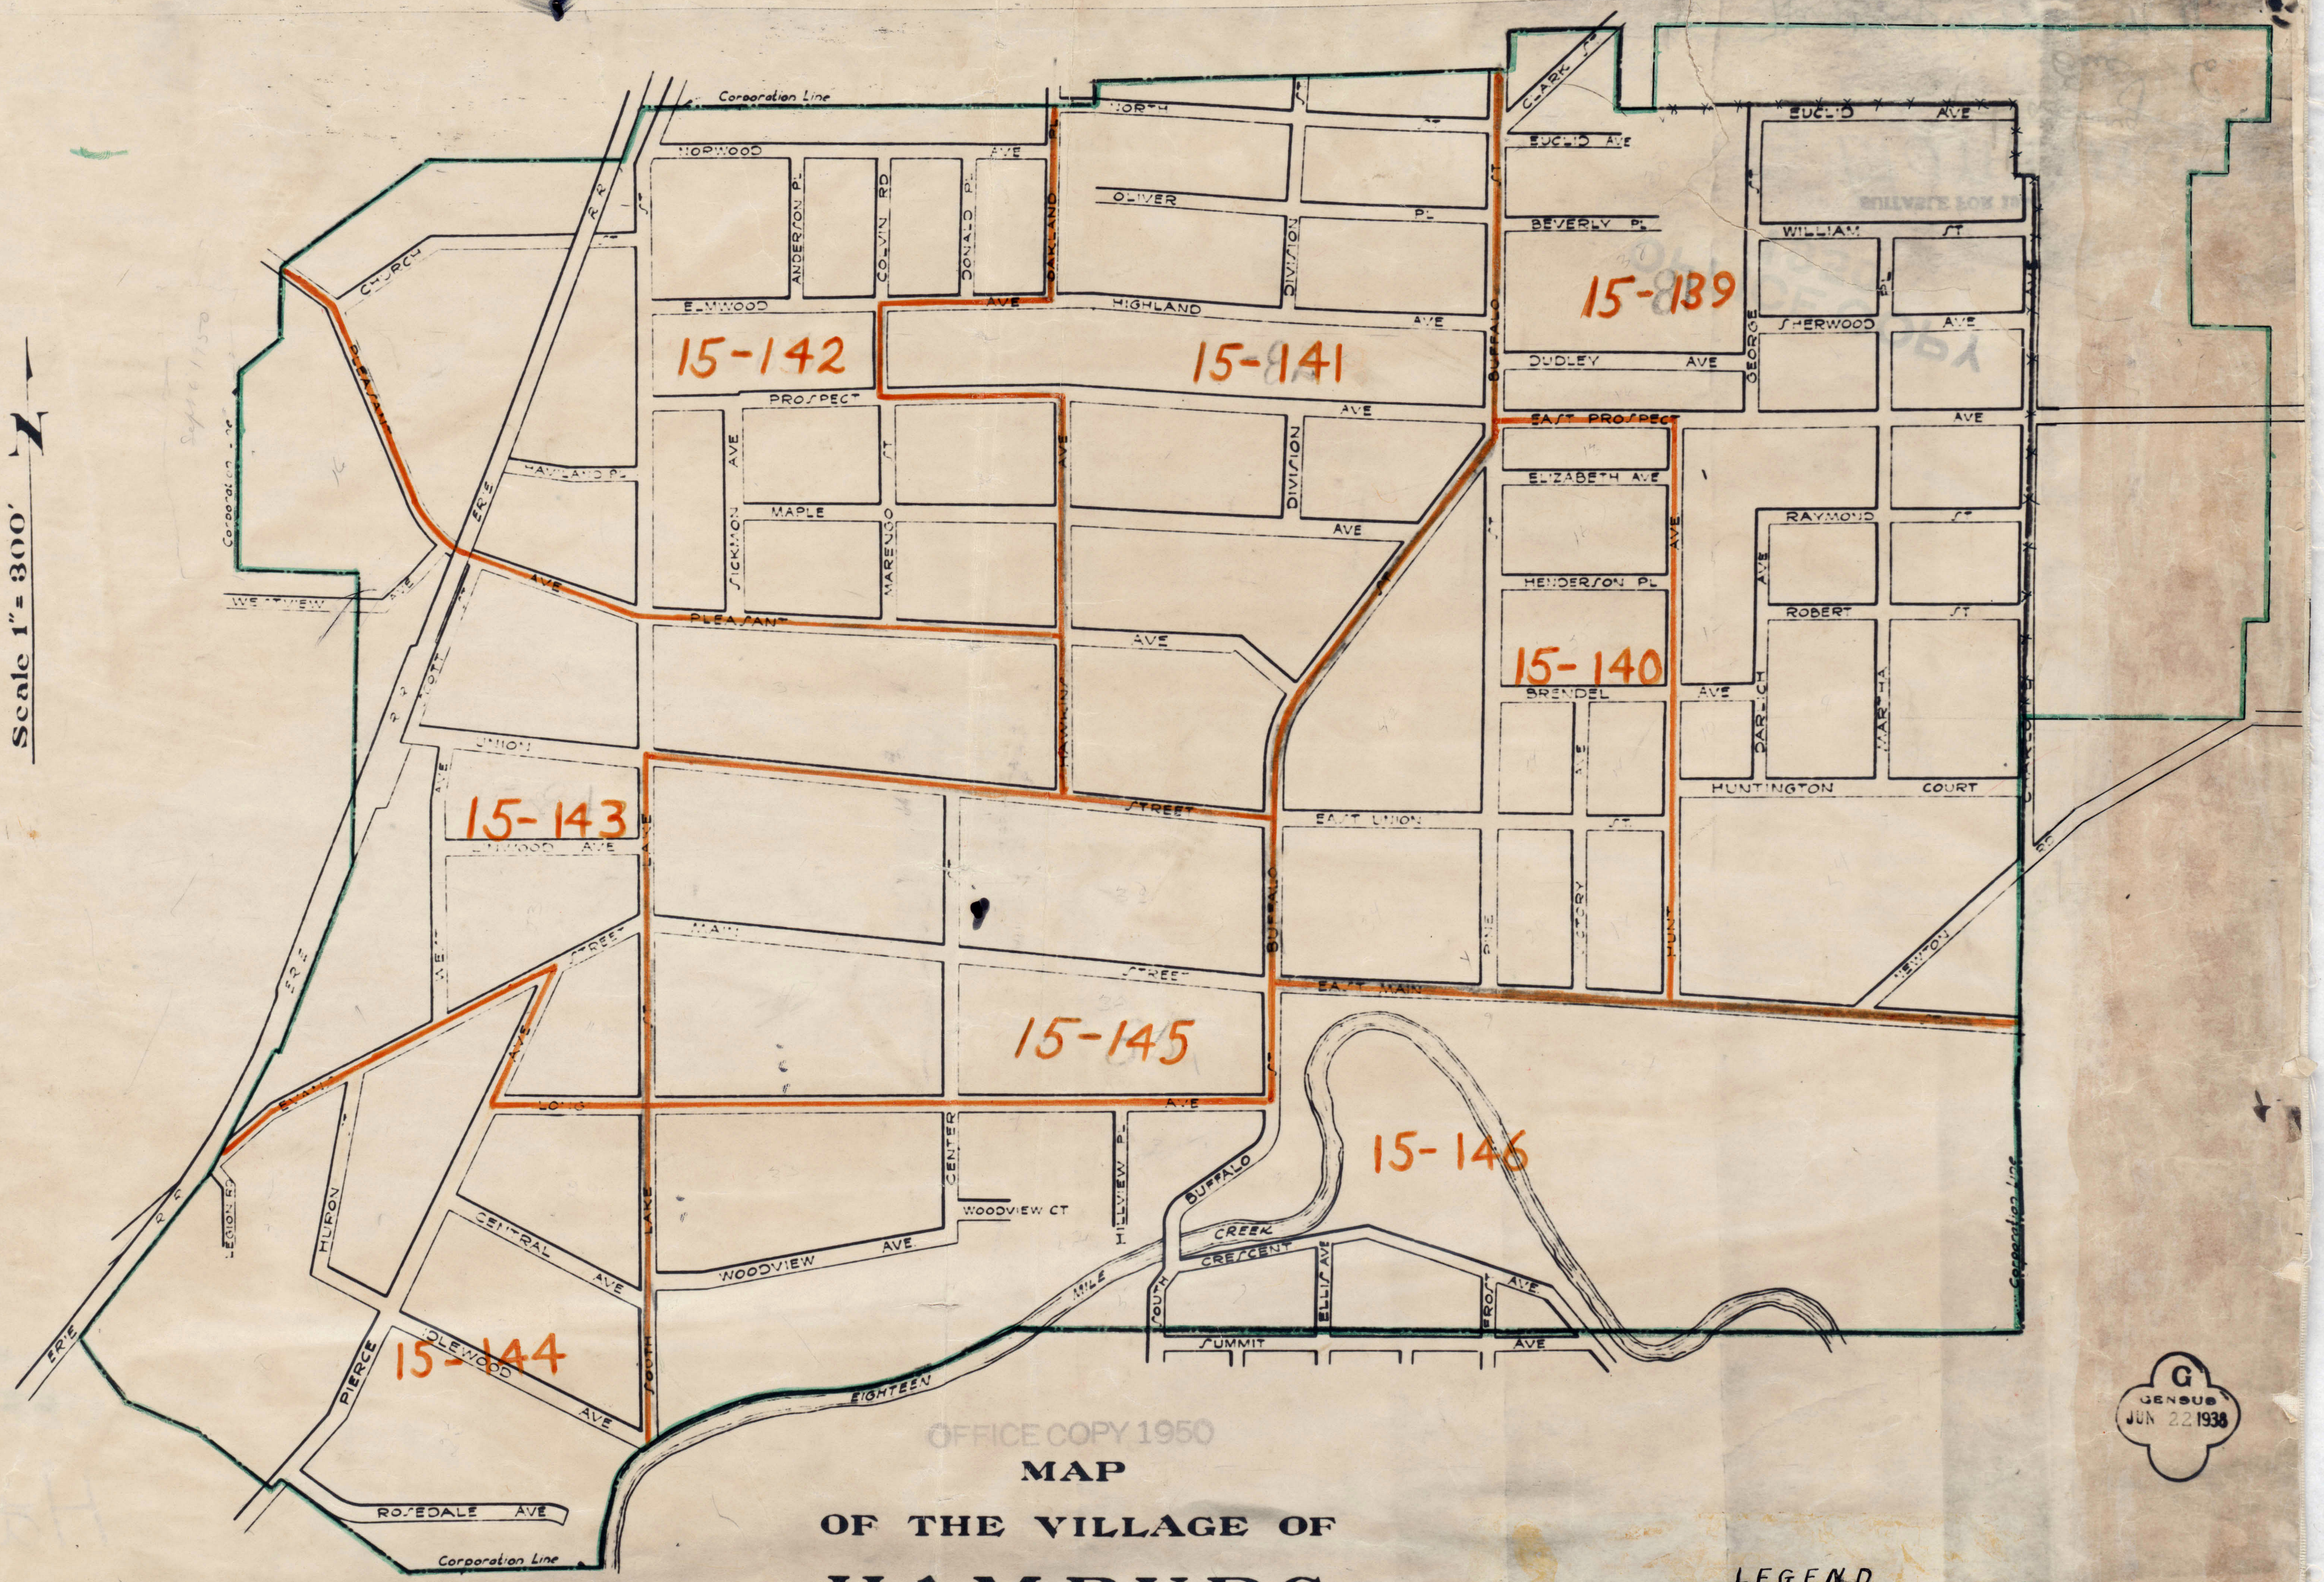

G CENSUS JUN 22 1938

OFFICE COPY 1950

# MAP
## OF THE VILLAGE OF
# HAMBURG
EDs 15-81 TO 15-85
## ERIE COUNTY, NEW YORK.

0 500 1000 Feet

LEGEND
Village Limits Green
E.D. Orange

LEGEND
Village Limits - Green

PARTLY WITHIN BUFFALO URBANIZED AREA

1950 OFFICE MAP

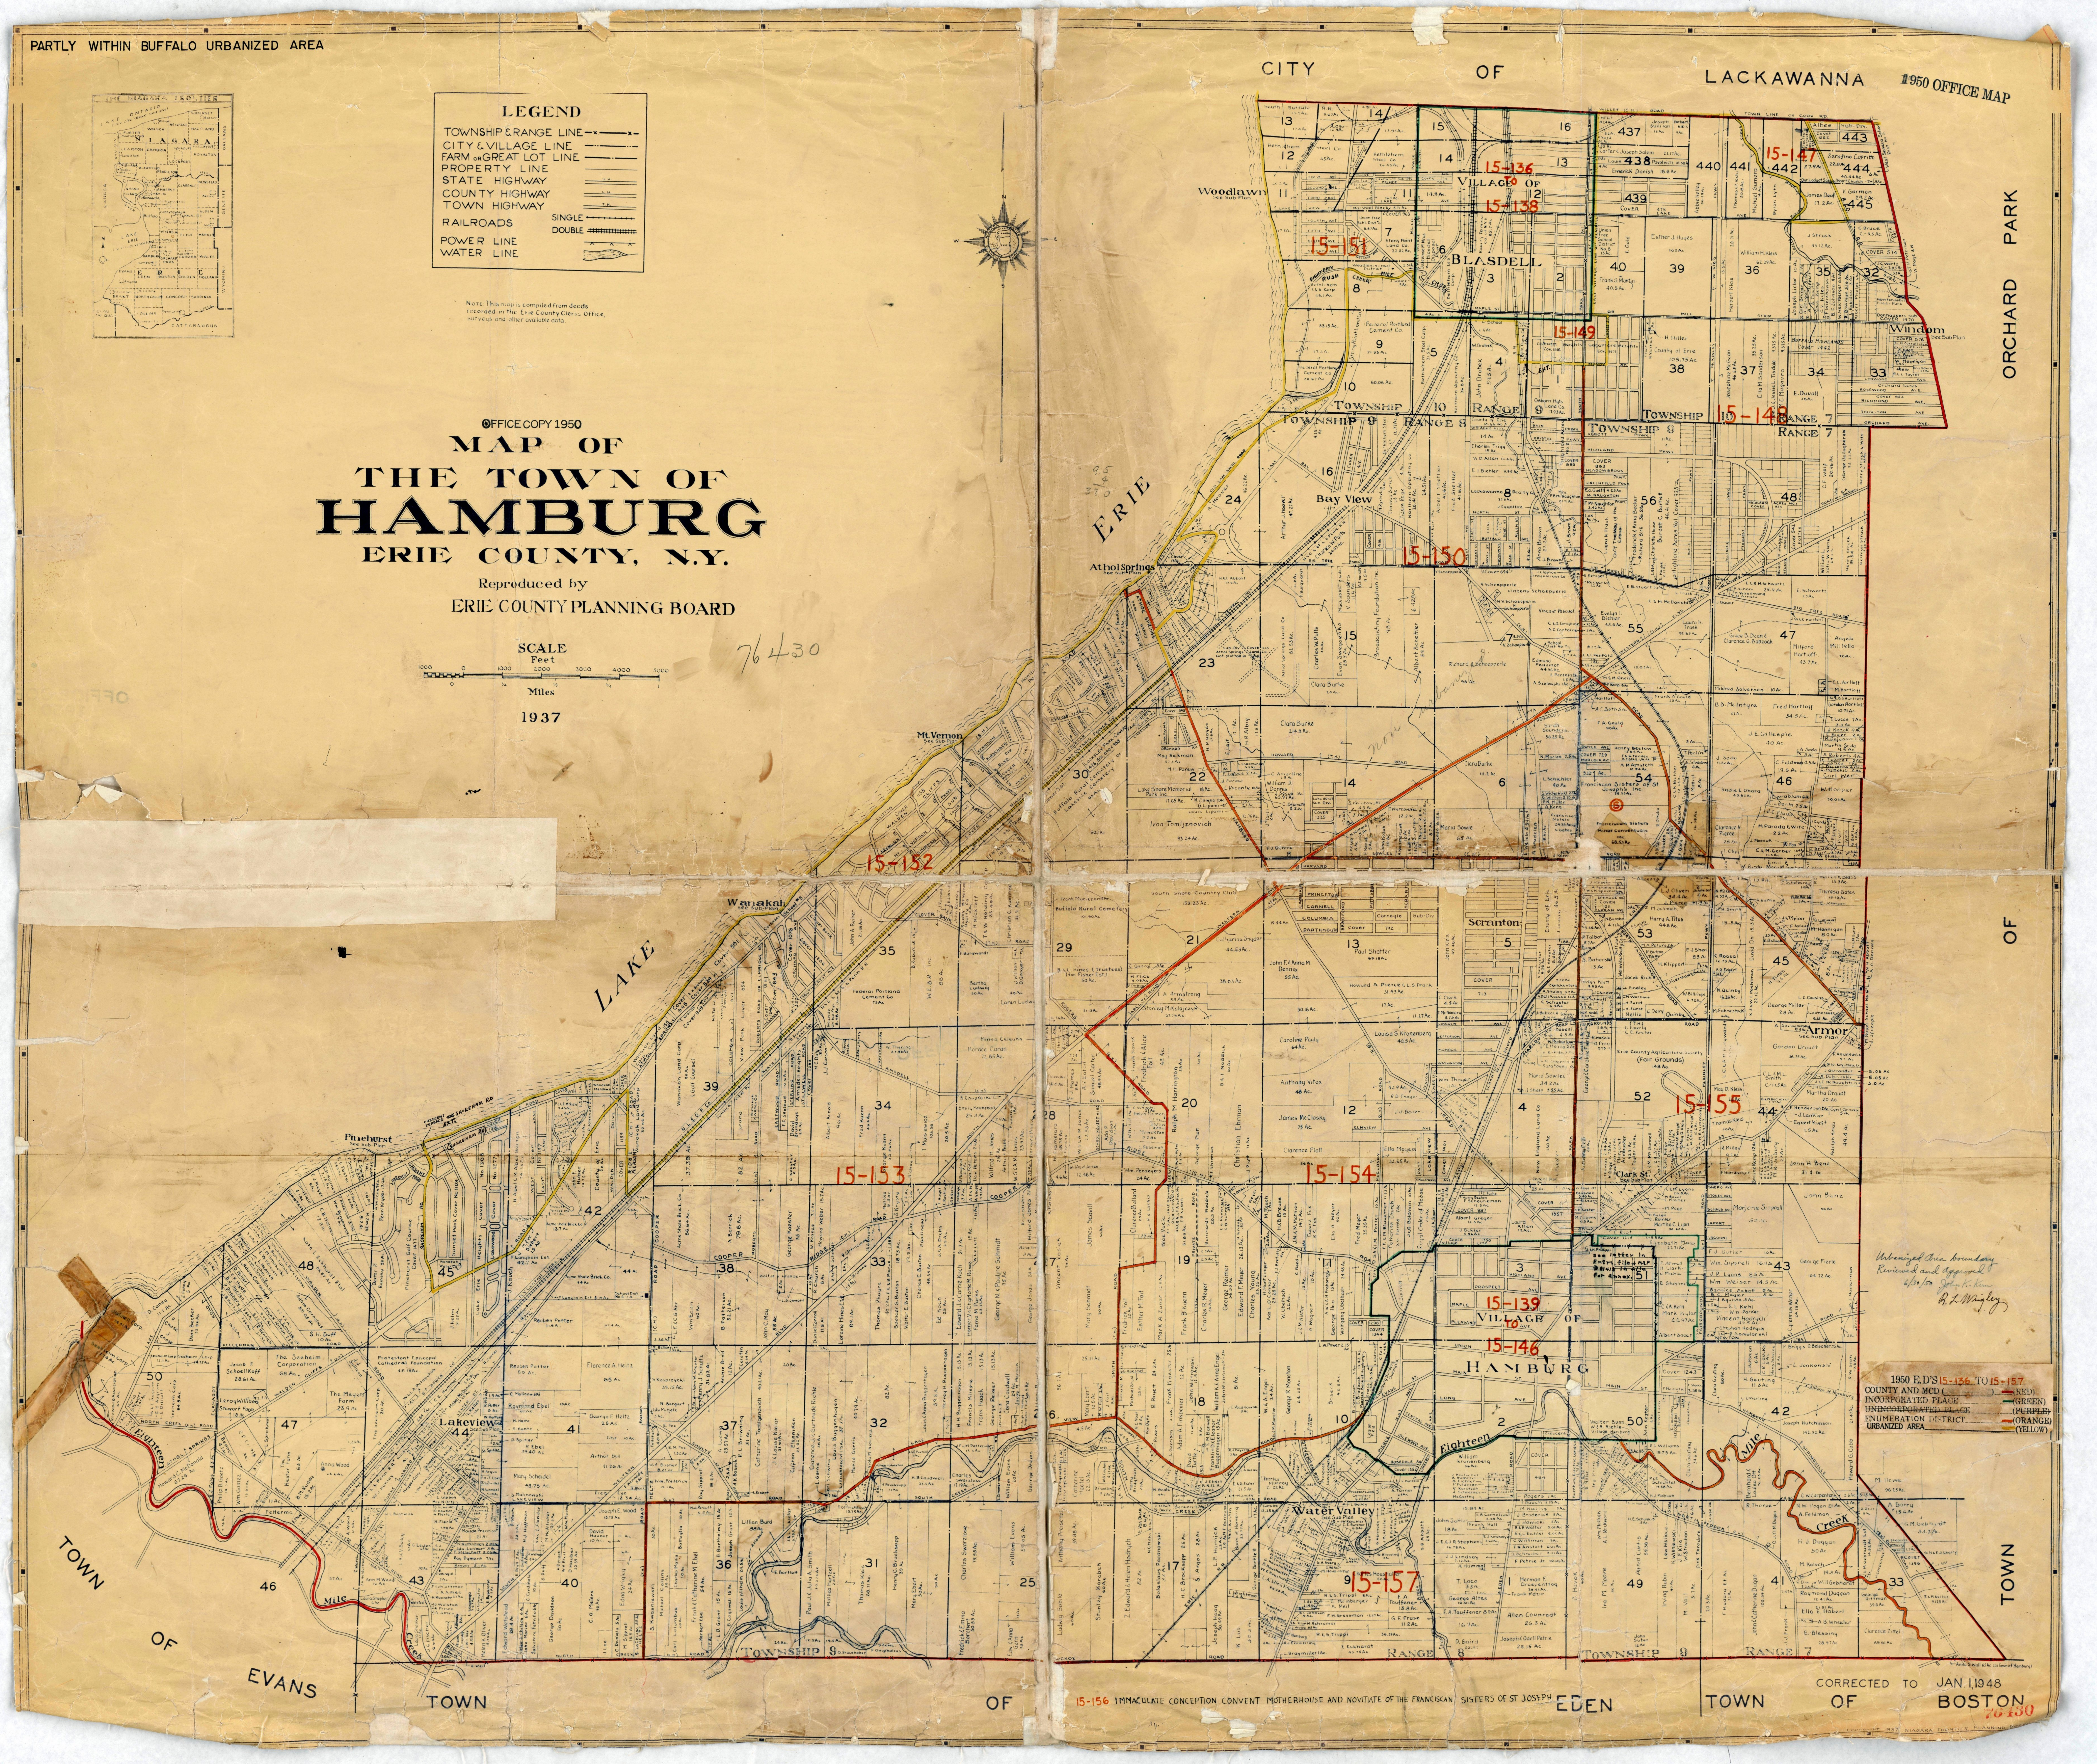

OFFICE COPY 1950

# MAP OF
# THE TOWN OF
# HAMBURG
## ERIE COUNTY, N.Y.

Reproduced by
ERIE COUNTY PLANNING BOARD

SCALE
Feet
1000 0 1000 2000 3000 4000 5000
Miles

1937

76430

### LEGEND

| | |
|---|---|
| TOWNSHIP & RANGE LINE | —×———×— |
| CITY & VILLAGE LINE | —··———··— |
| FARM OR GREAT LOT LINE | ——·—— |
| PROPERTY LINE | —— |
| STATE HIGHWAY | S.H. |
| COUNTY HIGHWAY | C.H. |
| TOWN HIGHWAY | T.H. |
| RAILROADS SINGLE | ┼┼┼┼ |
| RAILROADS DOUBLE | ╫╫╫╫ |
| POWER LINE | —⋏—⋏—⋏— |
| WATER LINE | |

NOTE: This map is compiled from deeds recorded in the Erie County Clerks Office, surveys and other available data.

1950 E.D'S 15-136 TO 15-157
COUNTY AND MCD ( ) (RED)
INCORPORATED PLACE (GREEN)
~~UNINCORPORATED PLACE~~ ~~(PURPLE)~~
ENUMERATION DISTRICT (ORANGE)
URBANIZED AREA (YELLOW)

Urbanized Area boundary
Reviewed and Approved
6/30/50 John K. Kern
R. L. Wrigley

15-156 IMMACULATE CONCEPTION CONVENT MOTHERHOUSE AND NOVITIATE OF THE FRANCISCAN SISTERS OF ST JOSEPH

CORRECTED TO JAN. 1, 1948

COPYRIGHT 1937 NIAGARA FRONTIER PLANNING BOARD

76430

ENTIRELY WITHIN BUFFALO URBANIZED AREA

1950 OFFICE MAP

OFFICE COPY 1950

ERIE COUNTY

# VILLAGE OF KENMORE
## New York

NEW YORK
Erie 30-15

APR 9 1948

I certify that the corporate limits shown on this map are correct as of March 31st, 1948.

Village Clerk
March 30 1948

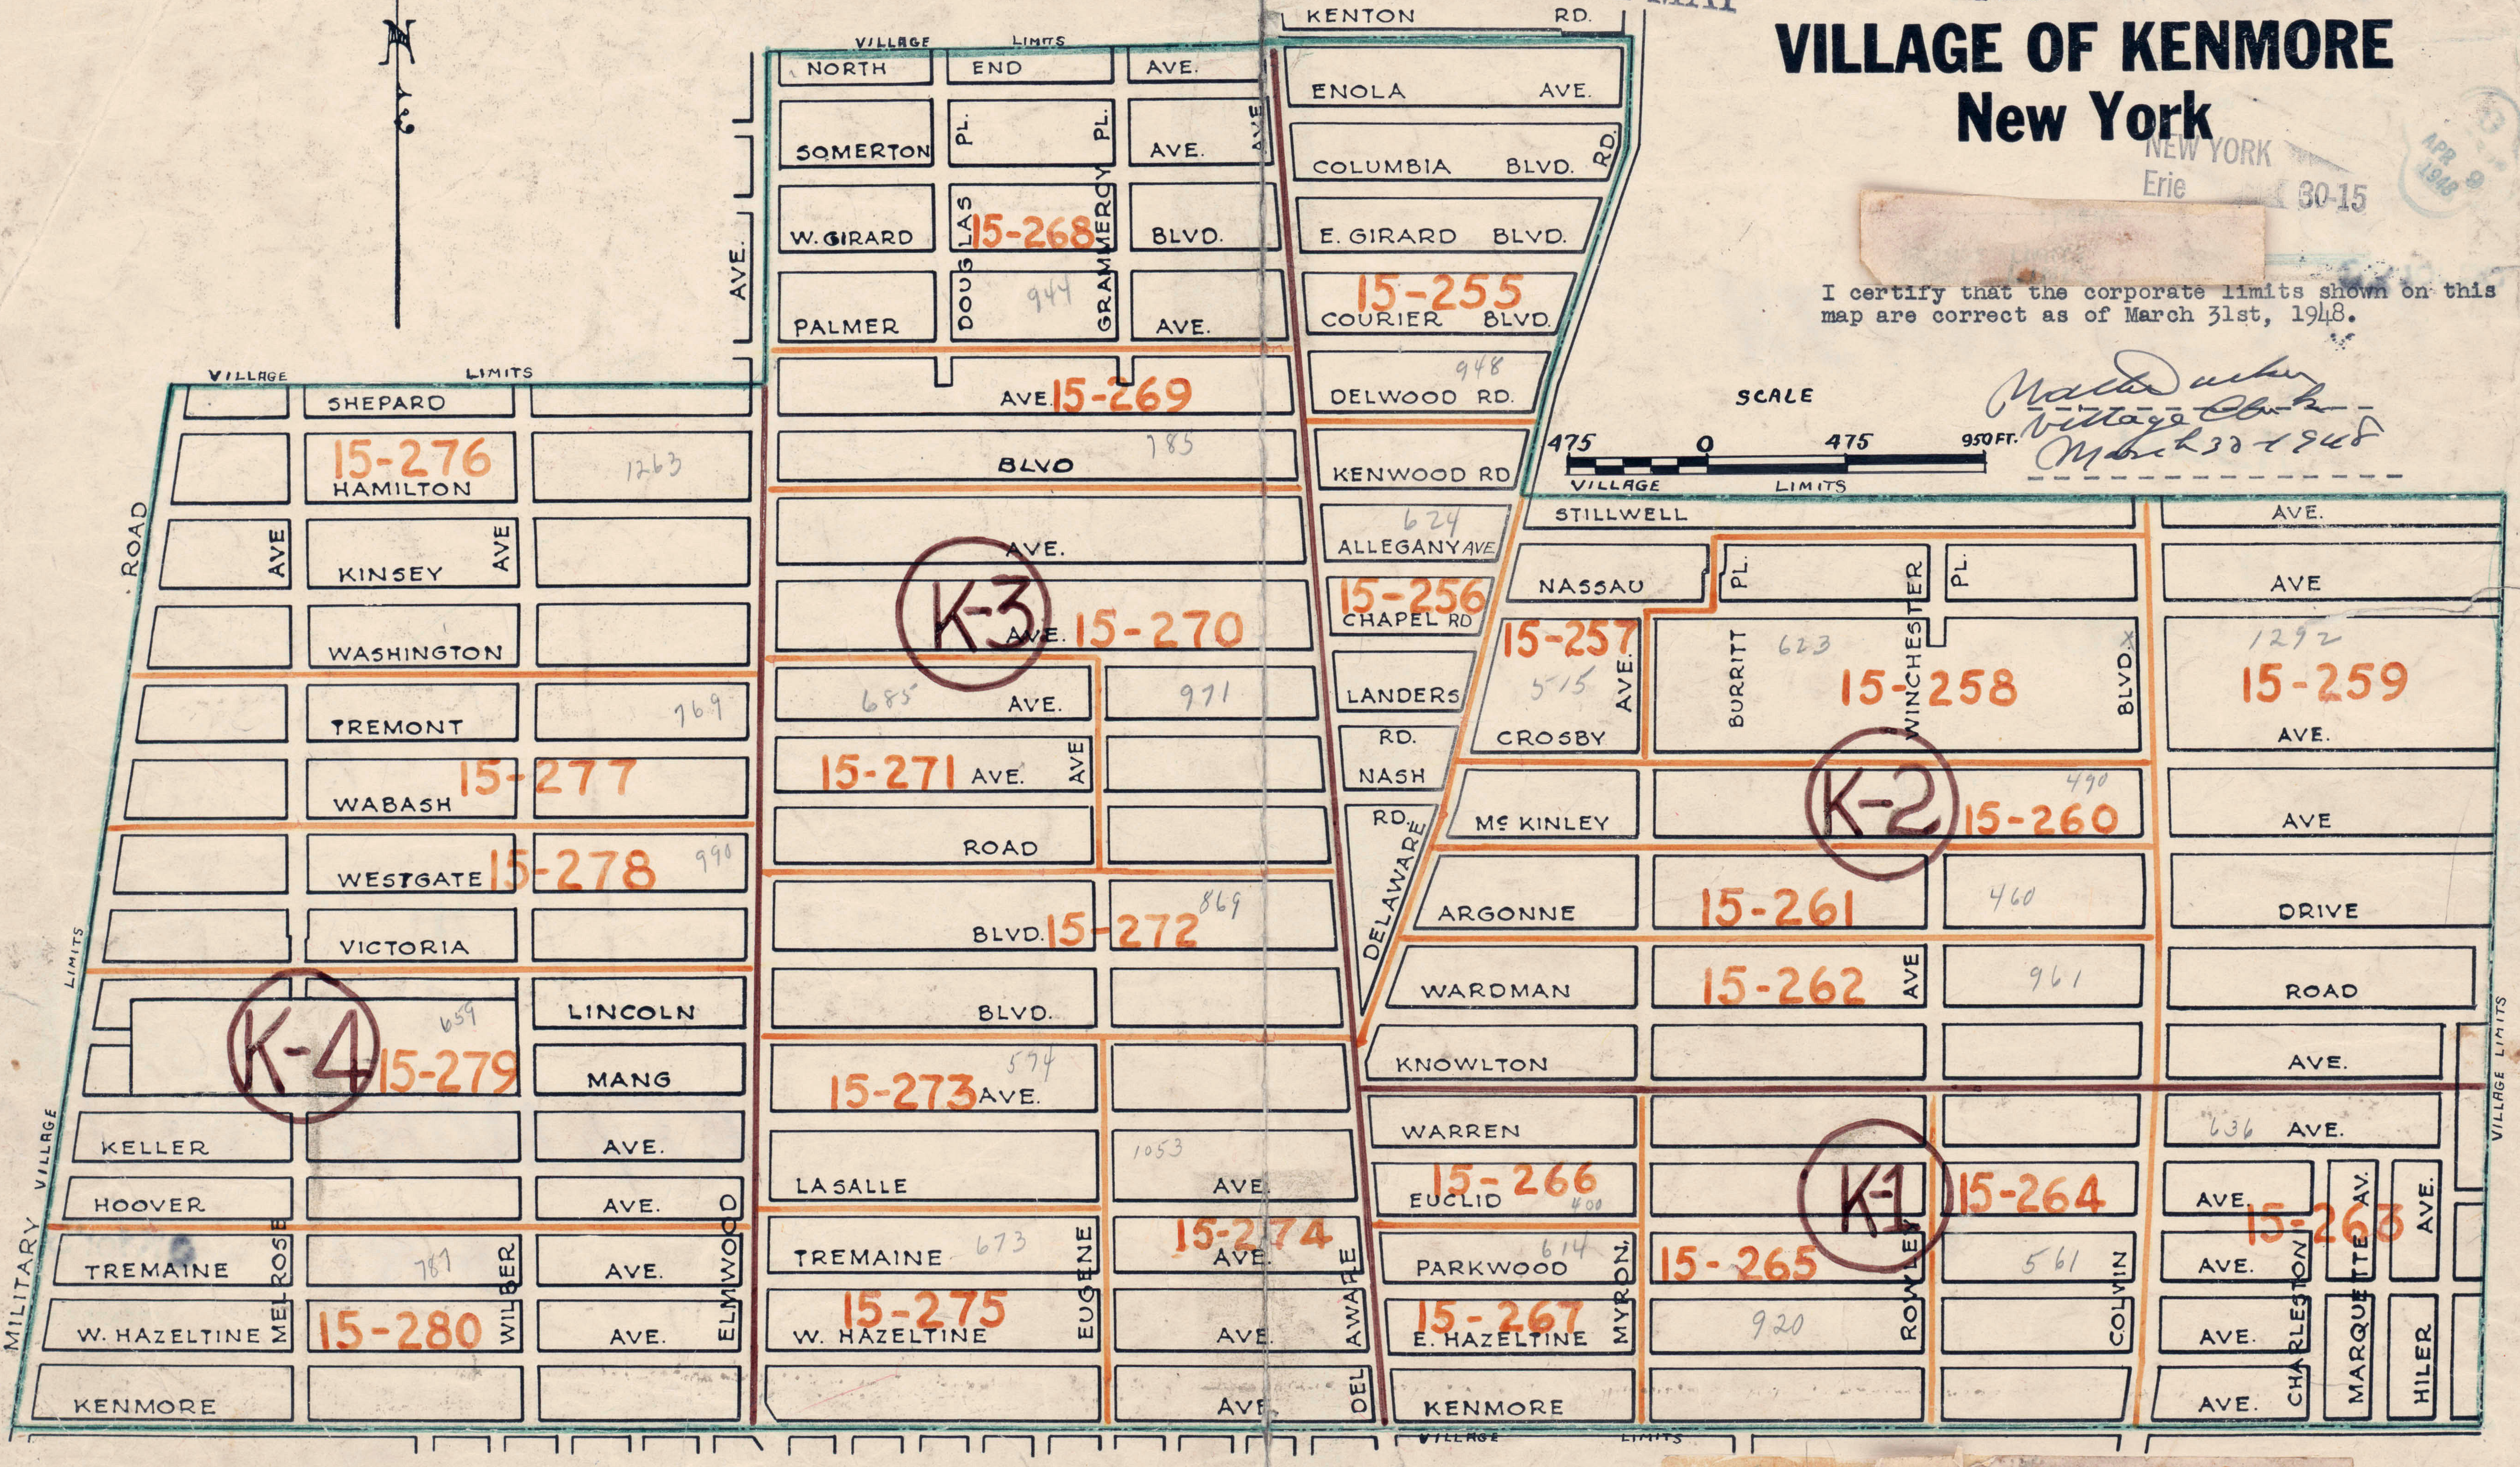

E.D'S 15-255 TO 15-280
LIMITS (GREEN)
N DISTRICT (ORANGE)
T K-2 (BROWN)

74204

ENTIRELY WITHIN BUFFALO URBANIZED AREA

1950 OFFICE MAP

1-7154

# CITY OF LACKAWANNA

ERIE Co., N.Y.

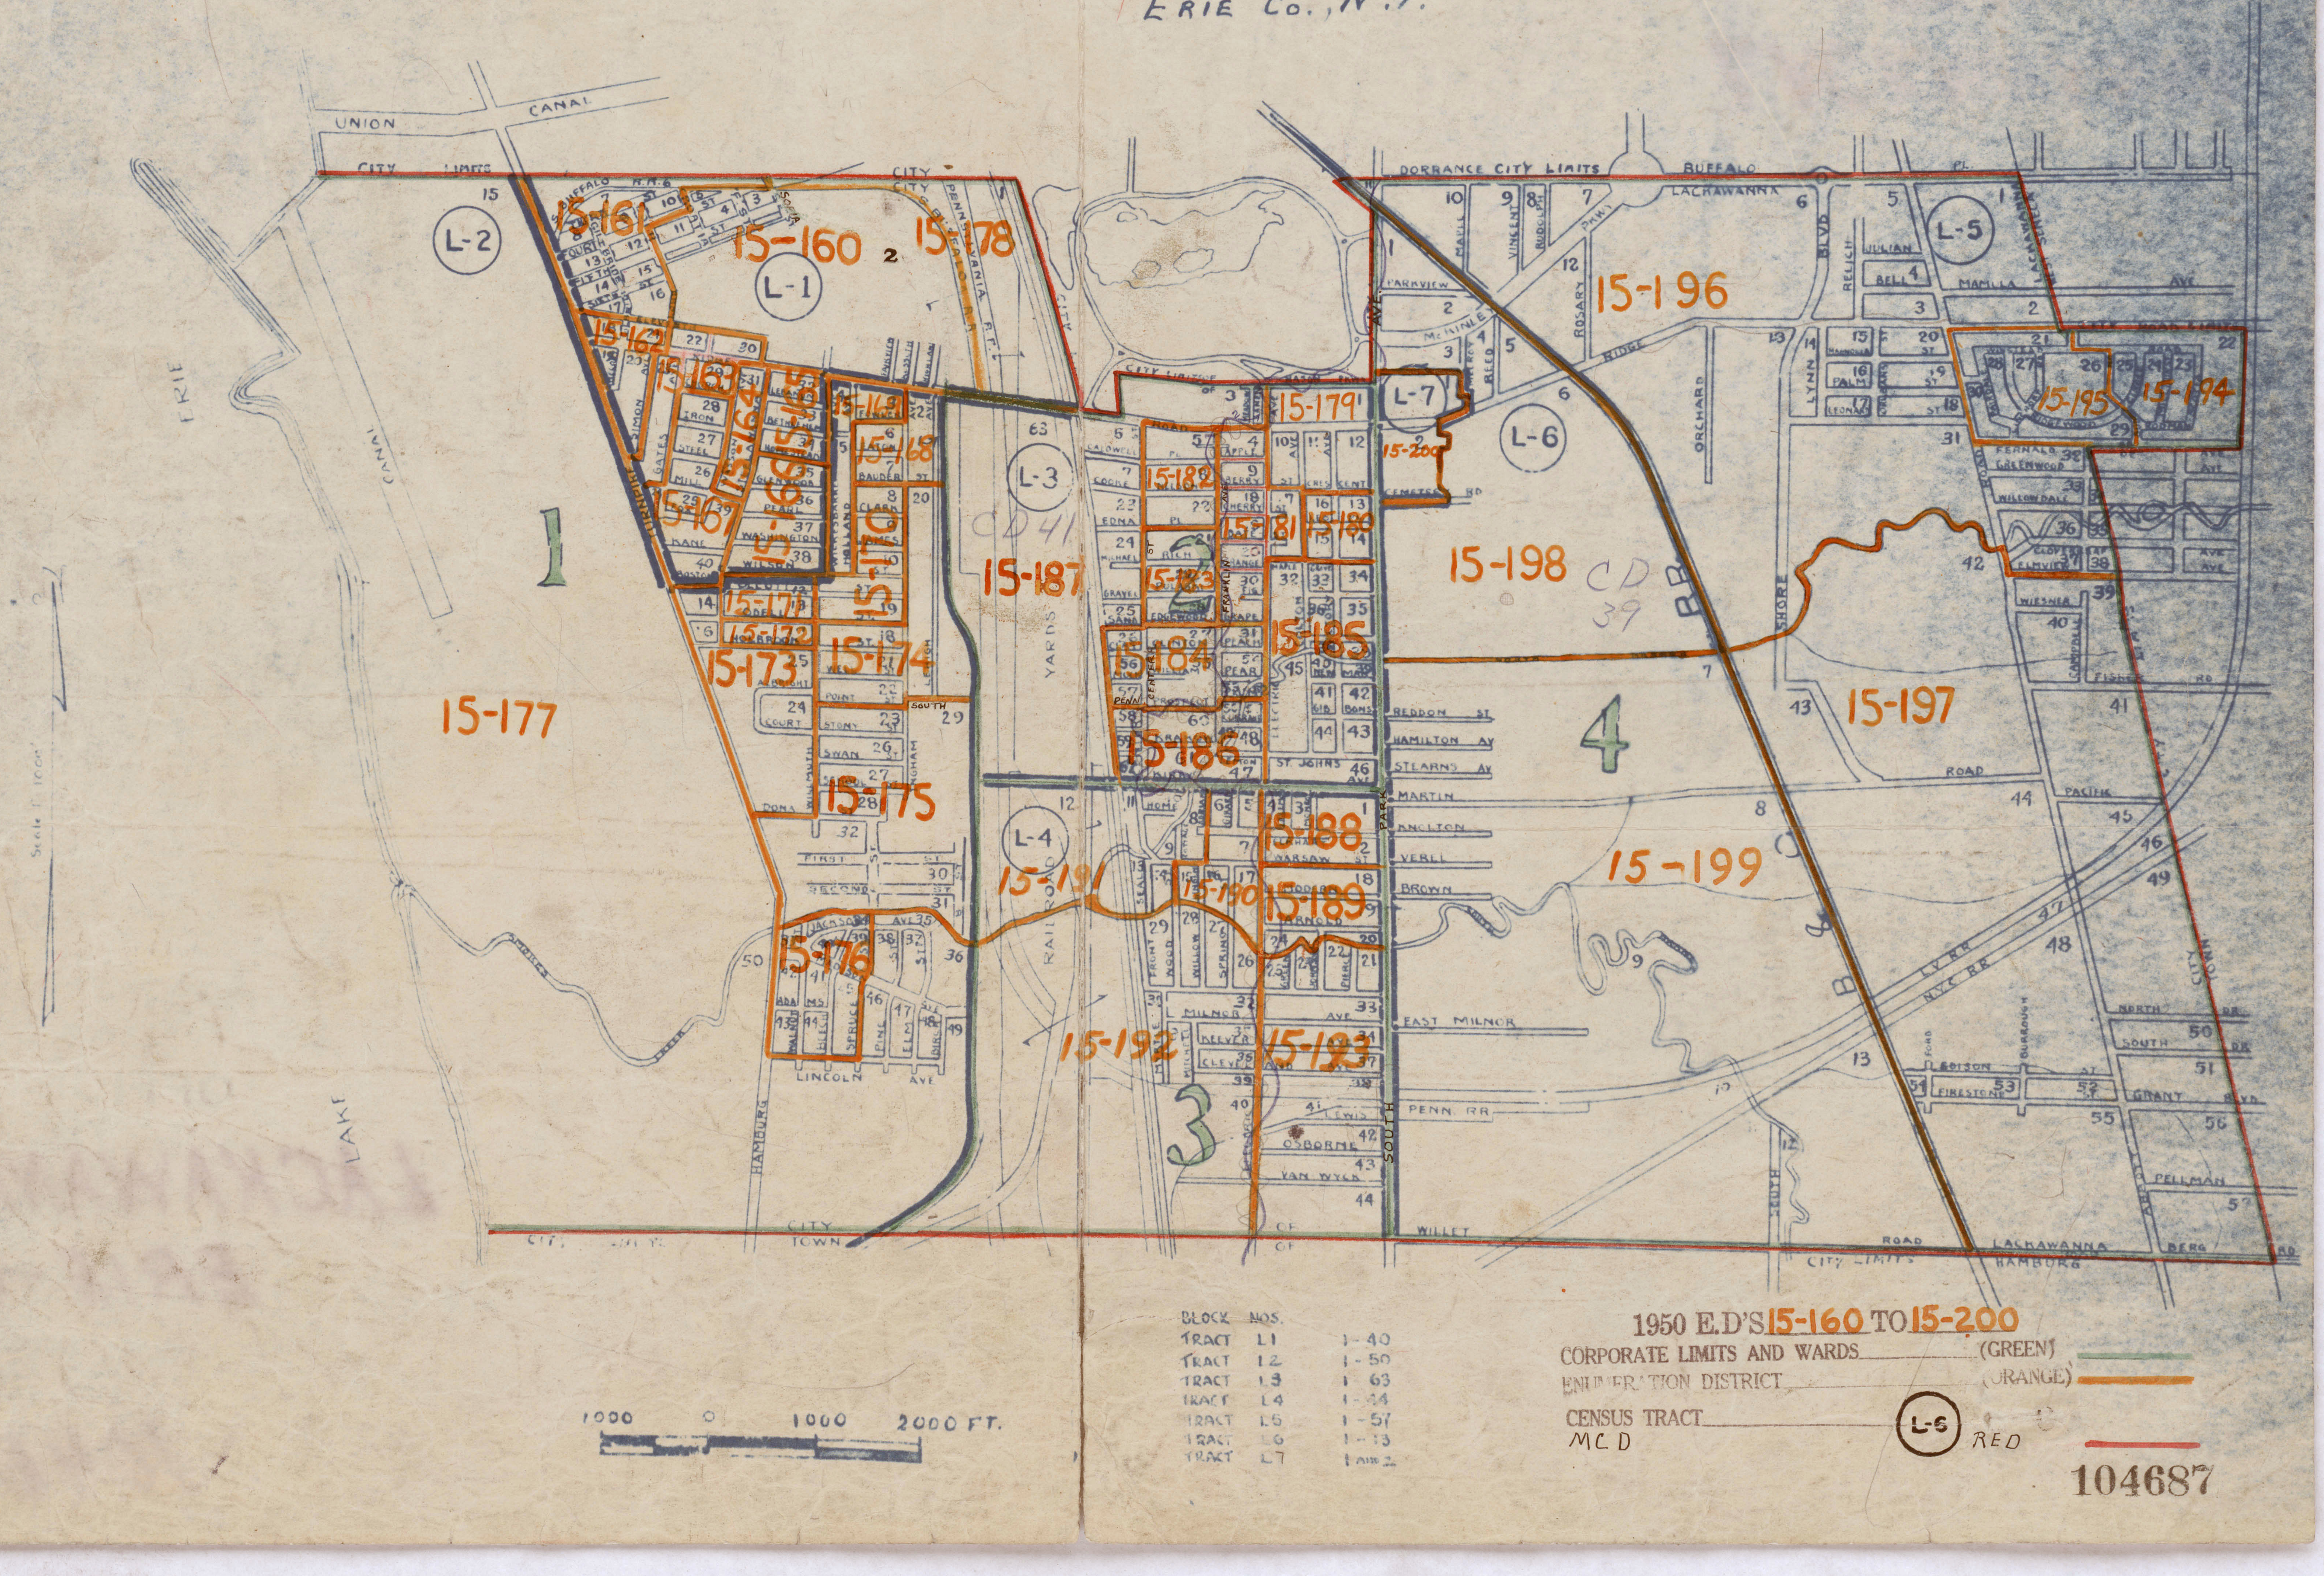

BLOCK NOS.

| | | |
|---|---|---|
| TRACT | L1 | 1-40 |
| TRACT | L2 | 1-50 |
| TRACT | L3 | 1 63 |
| TRACT | L4 | 1-44 |
| TRACT | L5 | 1-57 |
| TRACT | L6 | 1-13 |
| TRACT | L7 | 1 AND 2 |

1950 E.D'S 15-160 TO 15-200

CORPORATE LIMITS AND WARDS (GREEN) ▬

ENUMERATION DISTRICT (ORANGE) ▬

CENSUS TRACT L-6

MCD RED ▬

104687

43

B

1950 OFFICE MAP

# MAP OF
# THE TOWN OF
# LANCASTER
## ERIE COUNTY, N.Y.

Compiled by
**ERIE COUNTY PLANNING BOARD**

77761

LEGEND
- TOWNSHIP RANGE LINE
- SECTION LINE
- CITY OR VILLAGE LINE
- FARM OR GREAT LOT LINE
- PROPERTY LINE
- STATE HIGHWAY — GENESEE ST.
- COUNTY HIGHWAY — ELLICOTT RD.
- TOWN HIGHWAY — STUTZMAN RD.
- RAILROADS
- STREAMS
- PARKS

SCALE
Feet
Miles

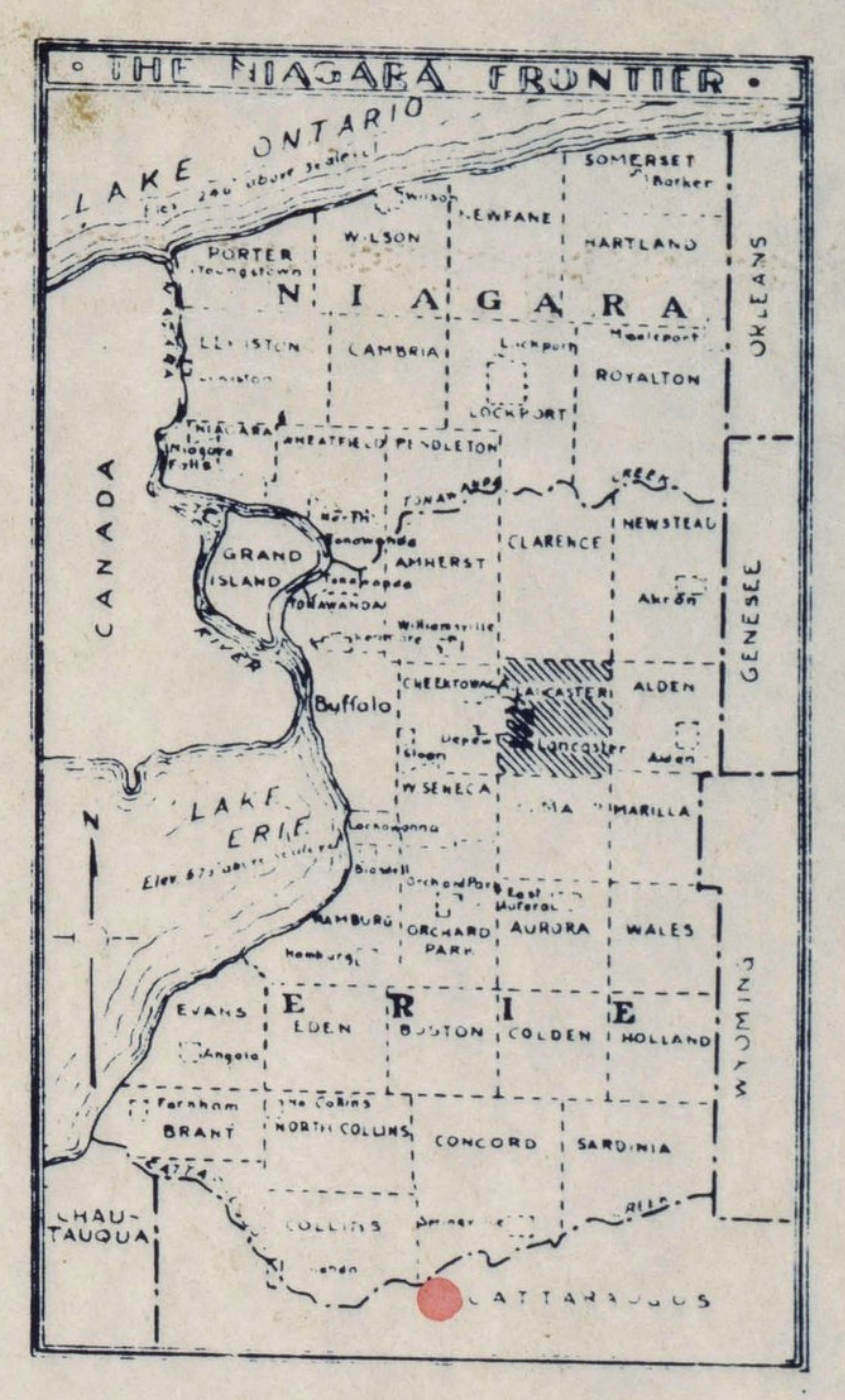

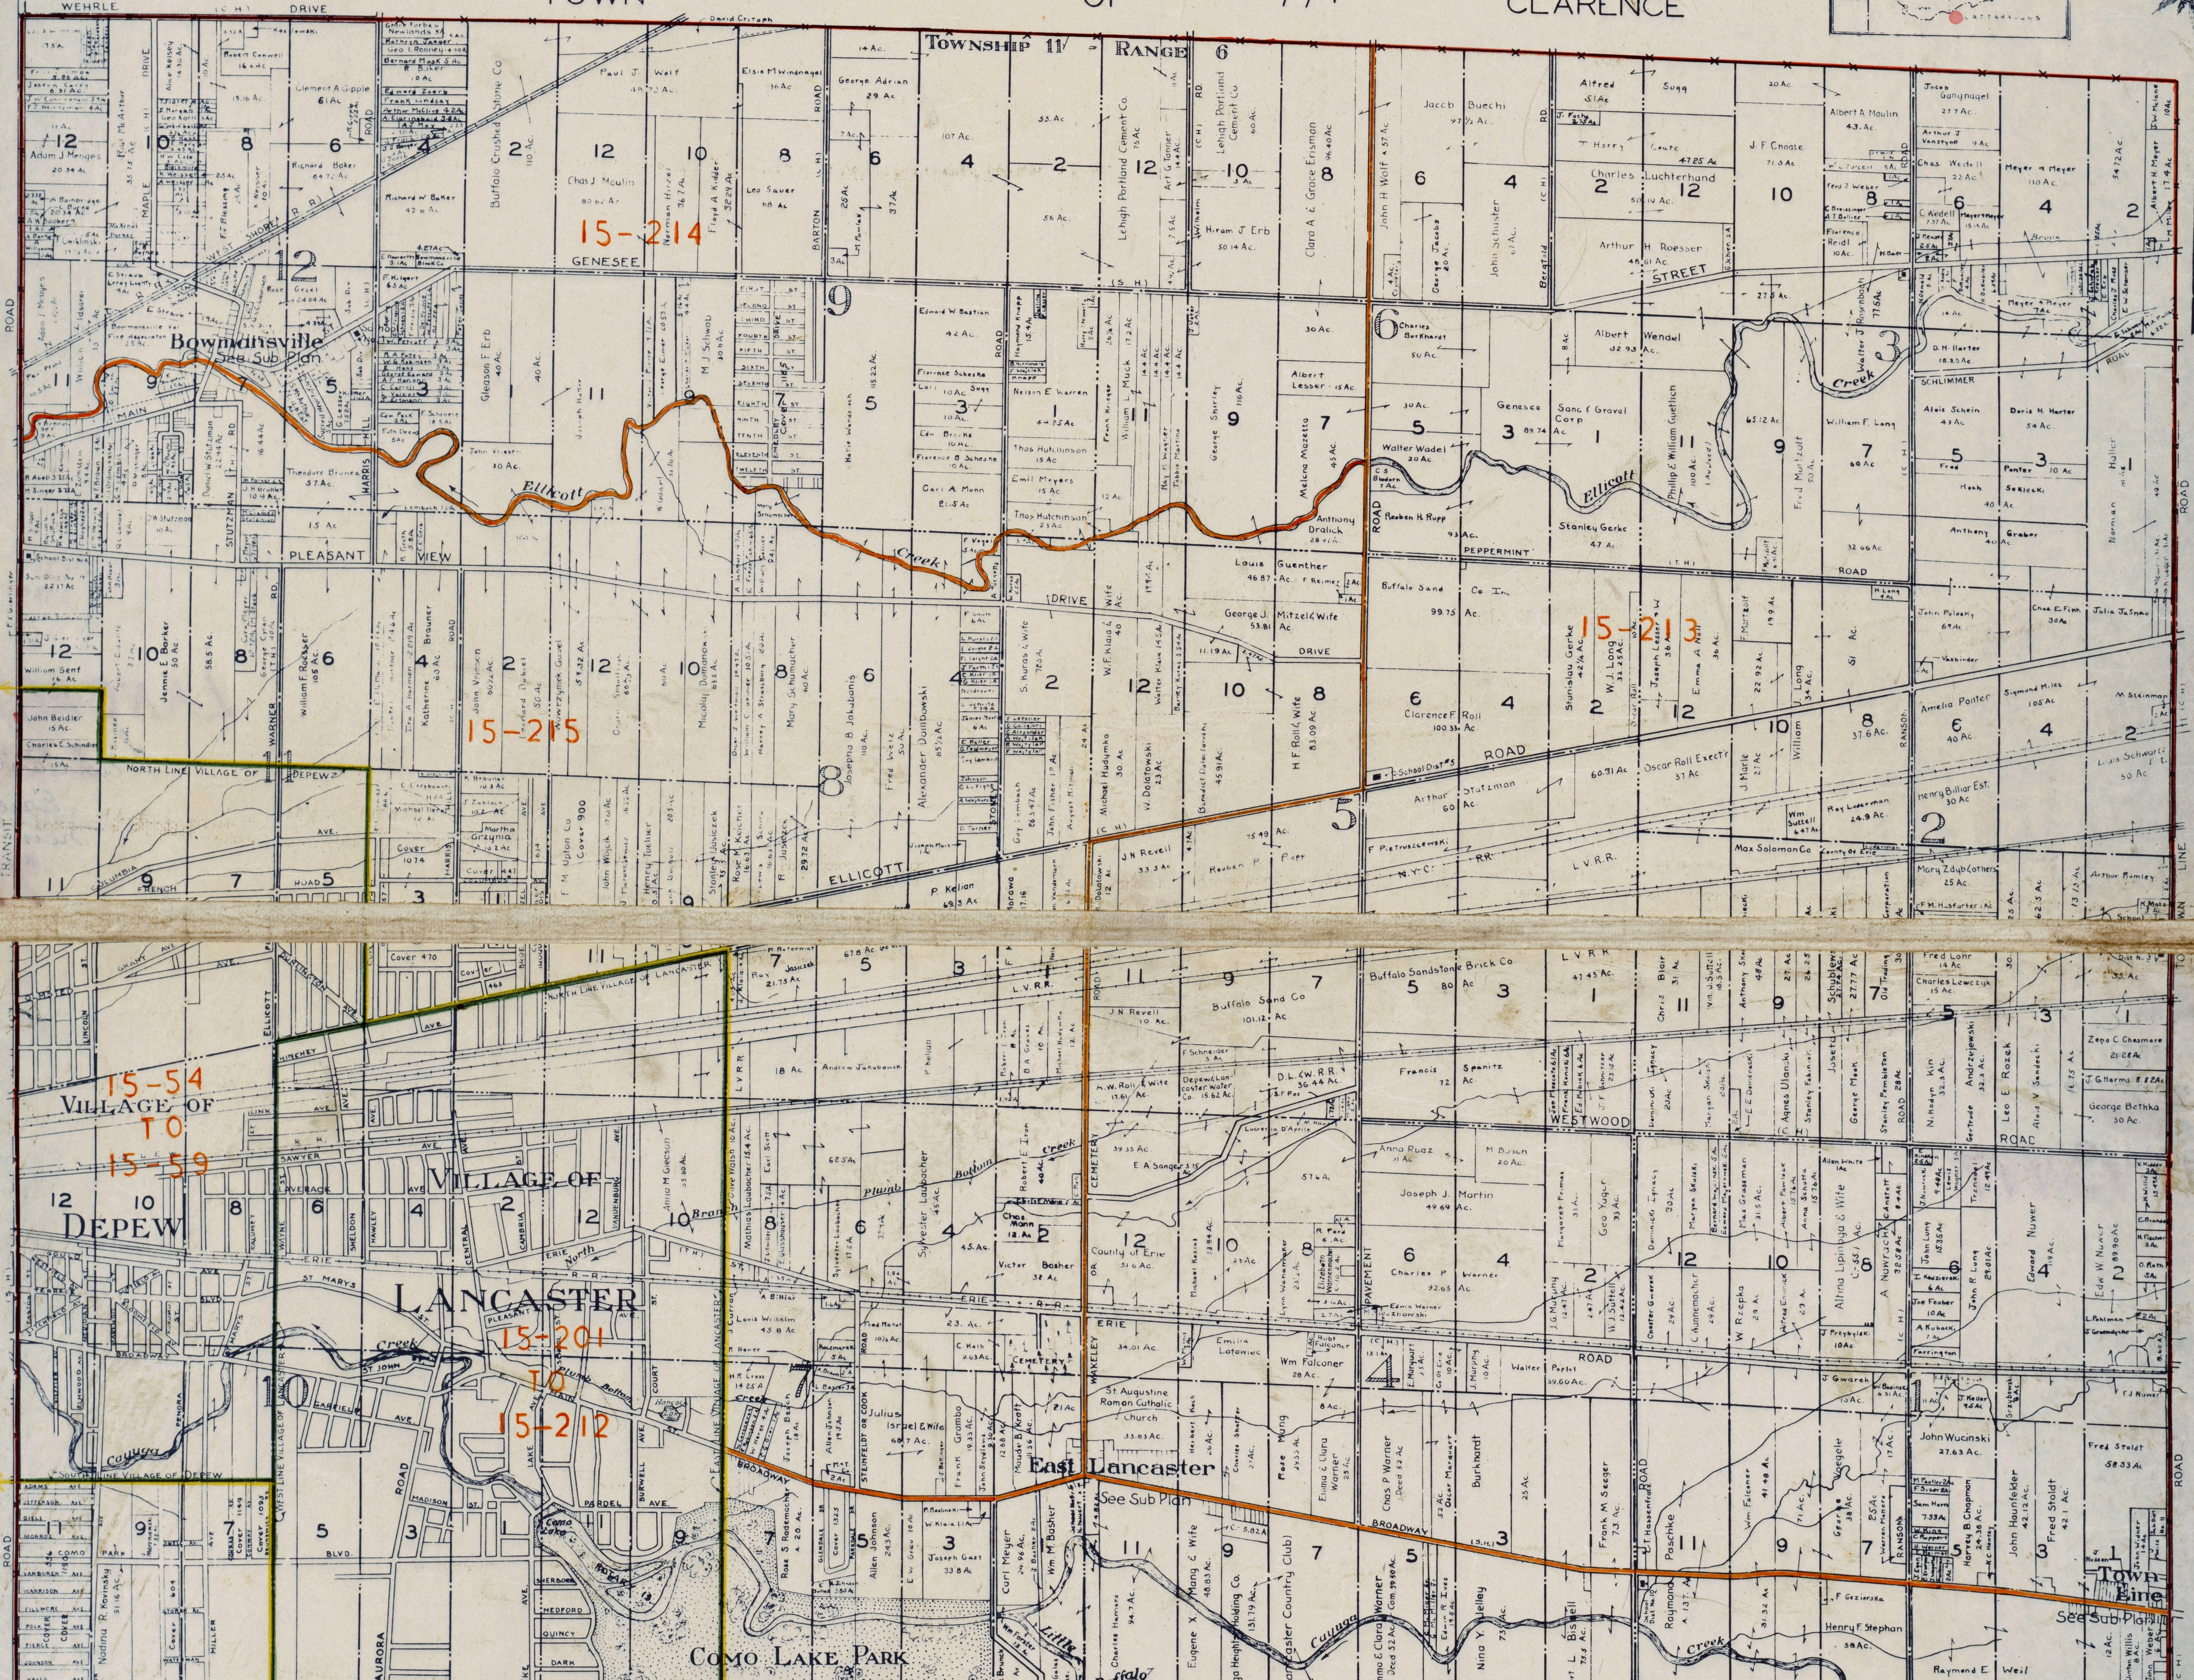

DUPLICATE COPY OF ORIGINAL 1950 OFFICE MAP PREPARED BY Ward
VERIFIED TO ORIGINAL 1950 OFFICE MAP & E.D. DESCRIPTIONS BY Henderson
DATE COPY WAS MADE 7-23-51

A

TOWN OF ELMA

PUBLISHED AS OF JANUARY 1948
NOTE: This map is compiled from deeds recorded in the Erie County Clerks Office, surveys and other available data.

1950 E.D'S 15-54 TO 15-
[redacted] MCD (______)____(RE Red ——
INCORPORATED PLACE________(GRE Green ——
[redacted]
ENUMERATION DISTRICT________(ORANGE
~~URBANIZED~~ AREA________(YELLOW

201 TO 15-216

Urbanized Area boundary reviewed and approved 6/30/50 John K. Kern & R. L. Wrigley
reviewed and approved for new copy map 7/2/51.
Sam Meltzer

77761 77761

1950 OFFICE MAP

RAILROADS SHOWN

73698

# OFFICE COPY 1950

VILLAGE OF
LANCASTER, N.Y.
REVISED TO JAN. 1st, 1948
HAROLD J. HUBER, SUPT. PUBLIC WORKS

ENTIRELY WITHIN BUFFALO URBANIZED AREA

NEW YORK
Erie 30-15

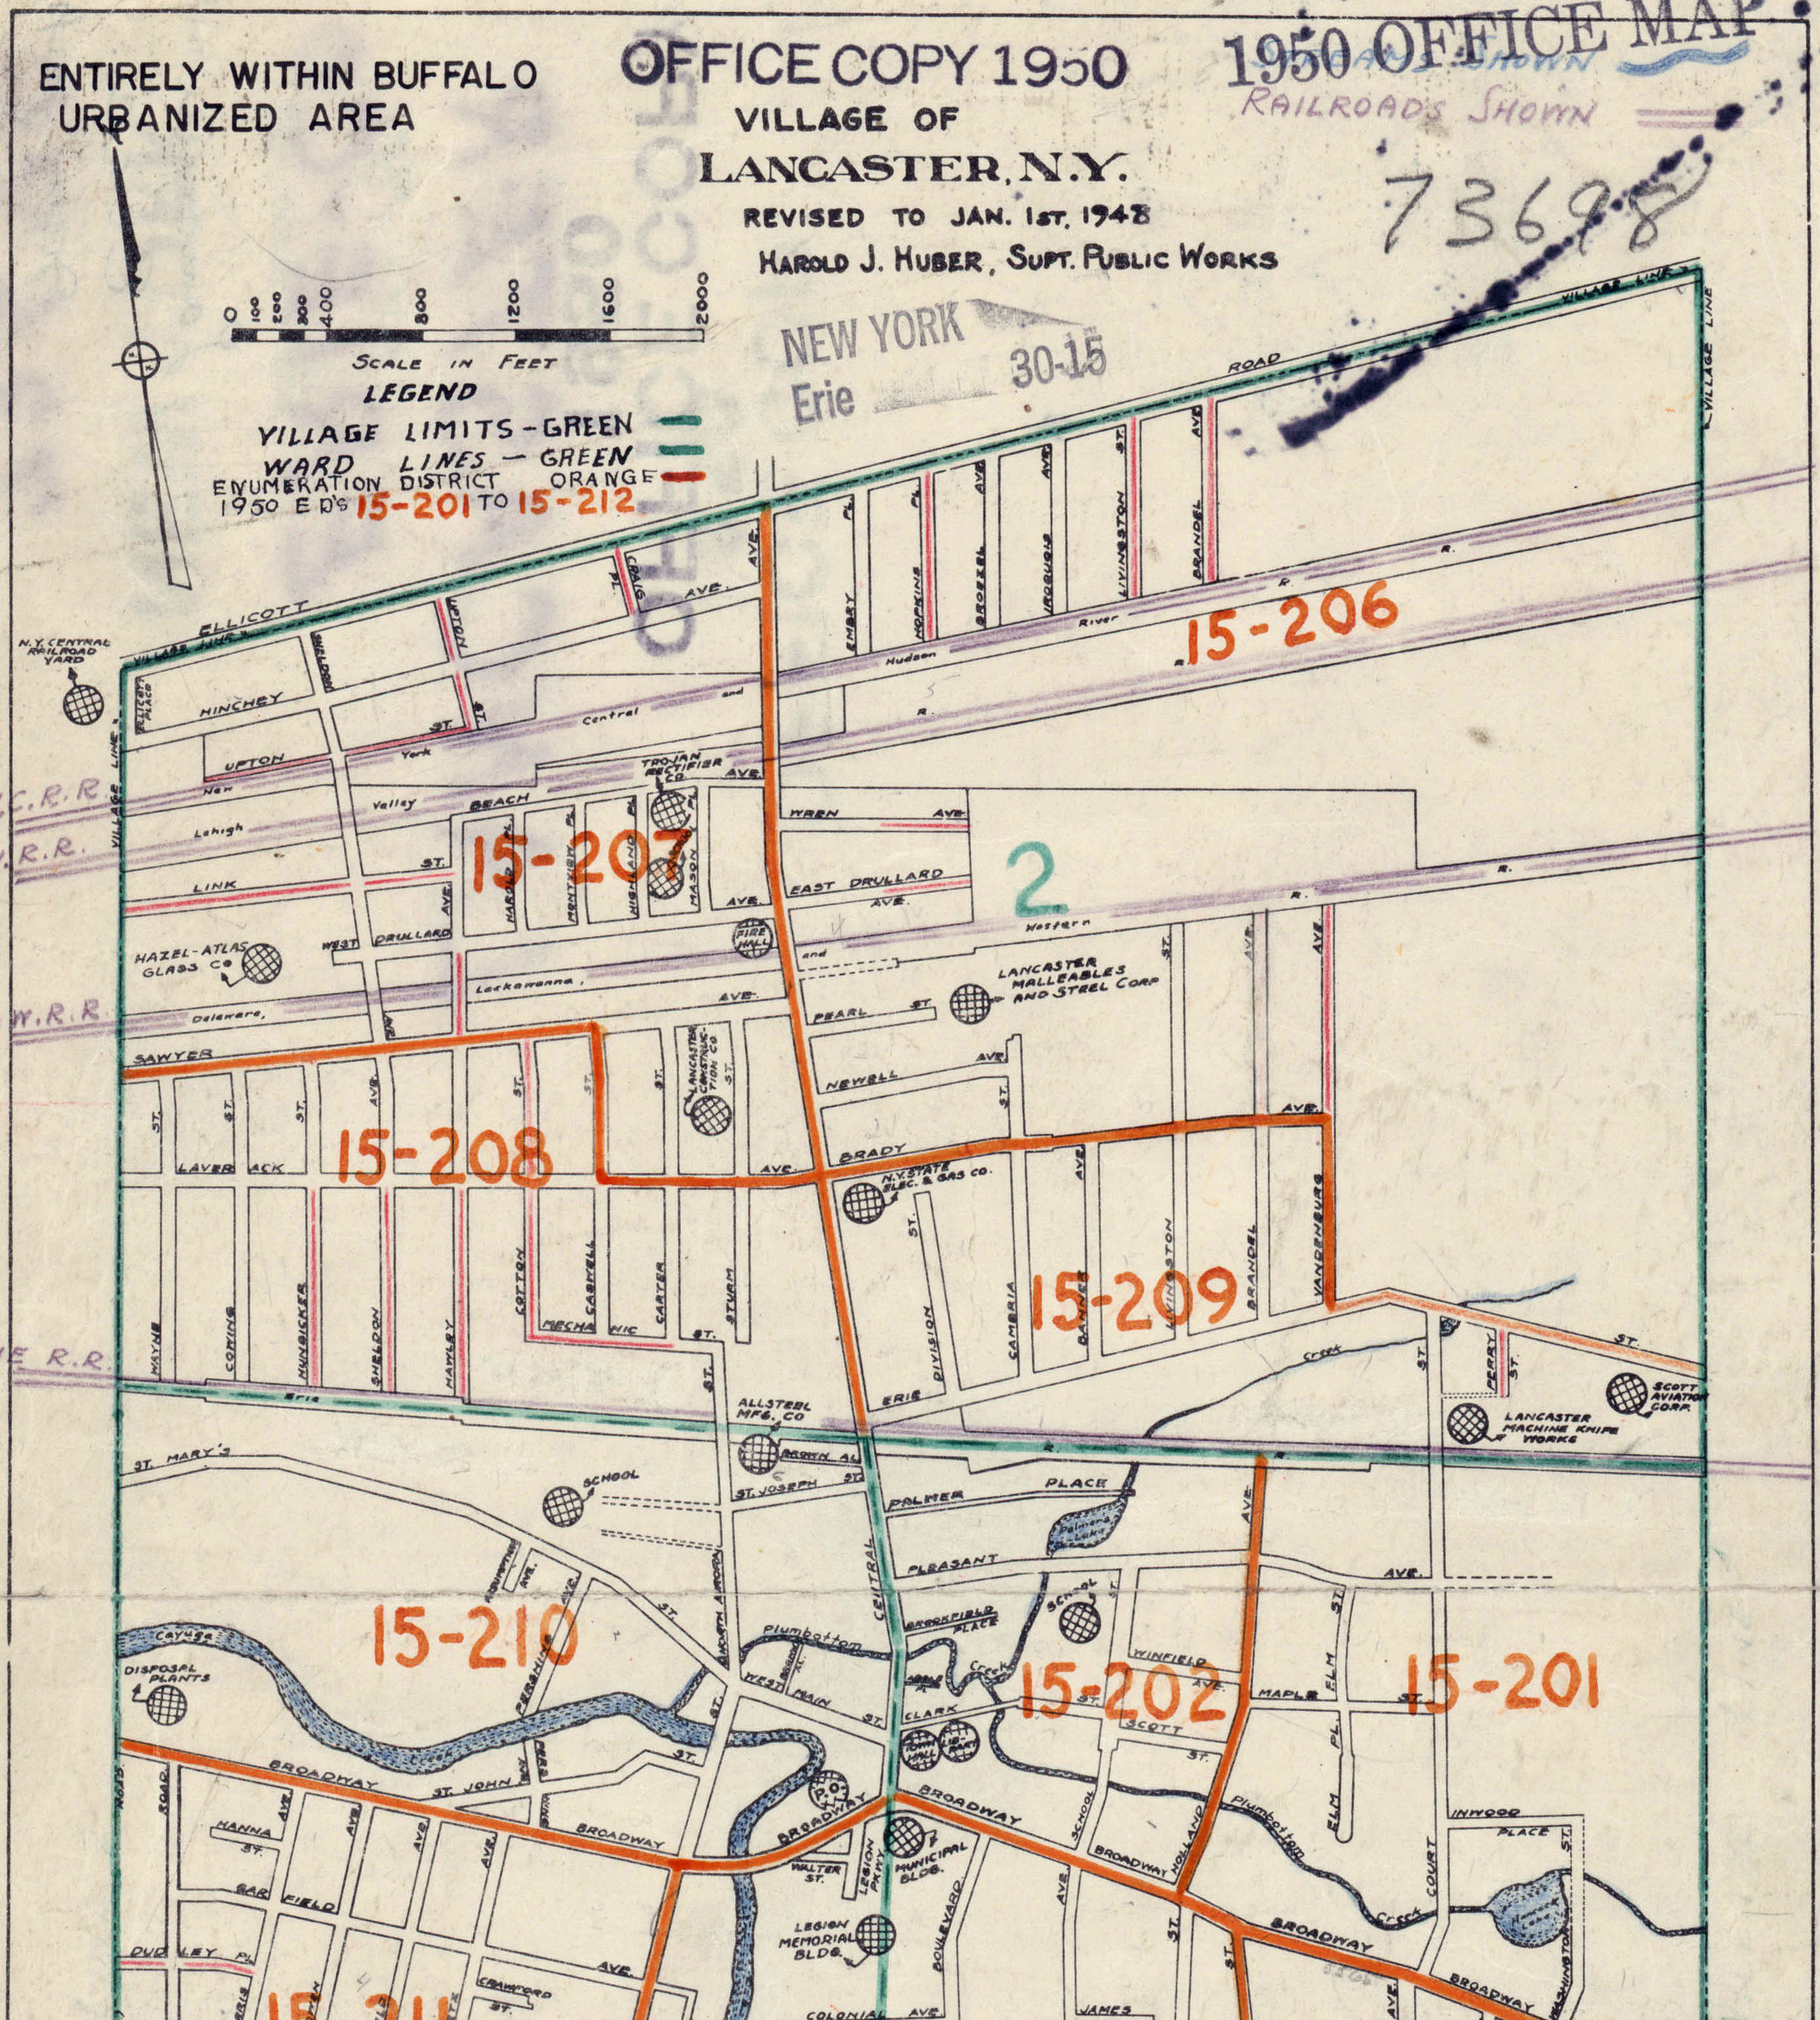

MAR 30 1948

NOTE: - Red line entered in middle of street indicates that street does not exist - Information entered by field man and local official

73698

CERTIFICATION: I certify that the corporate limits (and ward boundaries) shown on this map are correct as of January 1st, 1948.
(Signed) Harold J Huber
Harold J. Huber, Supt. Public Works.

OFFICE COPY 1950

1950 OFFICE MAP

# MAP OF THE TOWN OF ORCHARD PARK
## ERIE COUNTY, N.Y.

Compiled by
ERIE COUNTY PLANNING BOARD

PUBLISHED AS OF JANUARY 1948

NOTE: THIS MAP IS COMPILED FROM DEEDS RECORDED IN THE ERIE COUNTY CLERKS OFFICE, SURVEYS AND OTHER AVAILABLED DATA.

77766

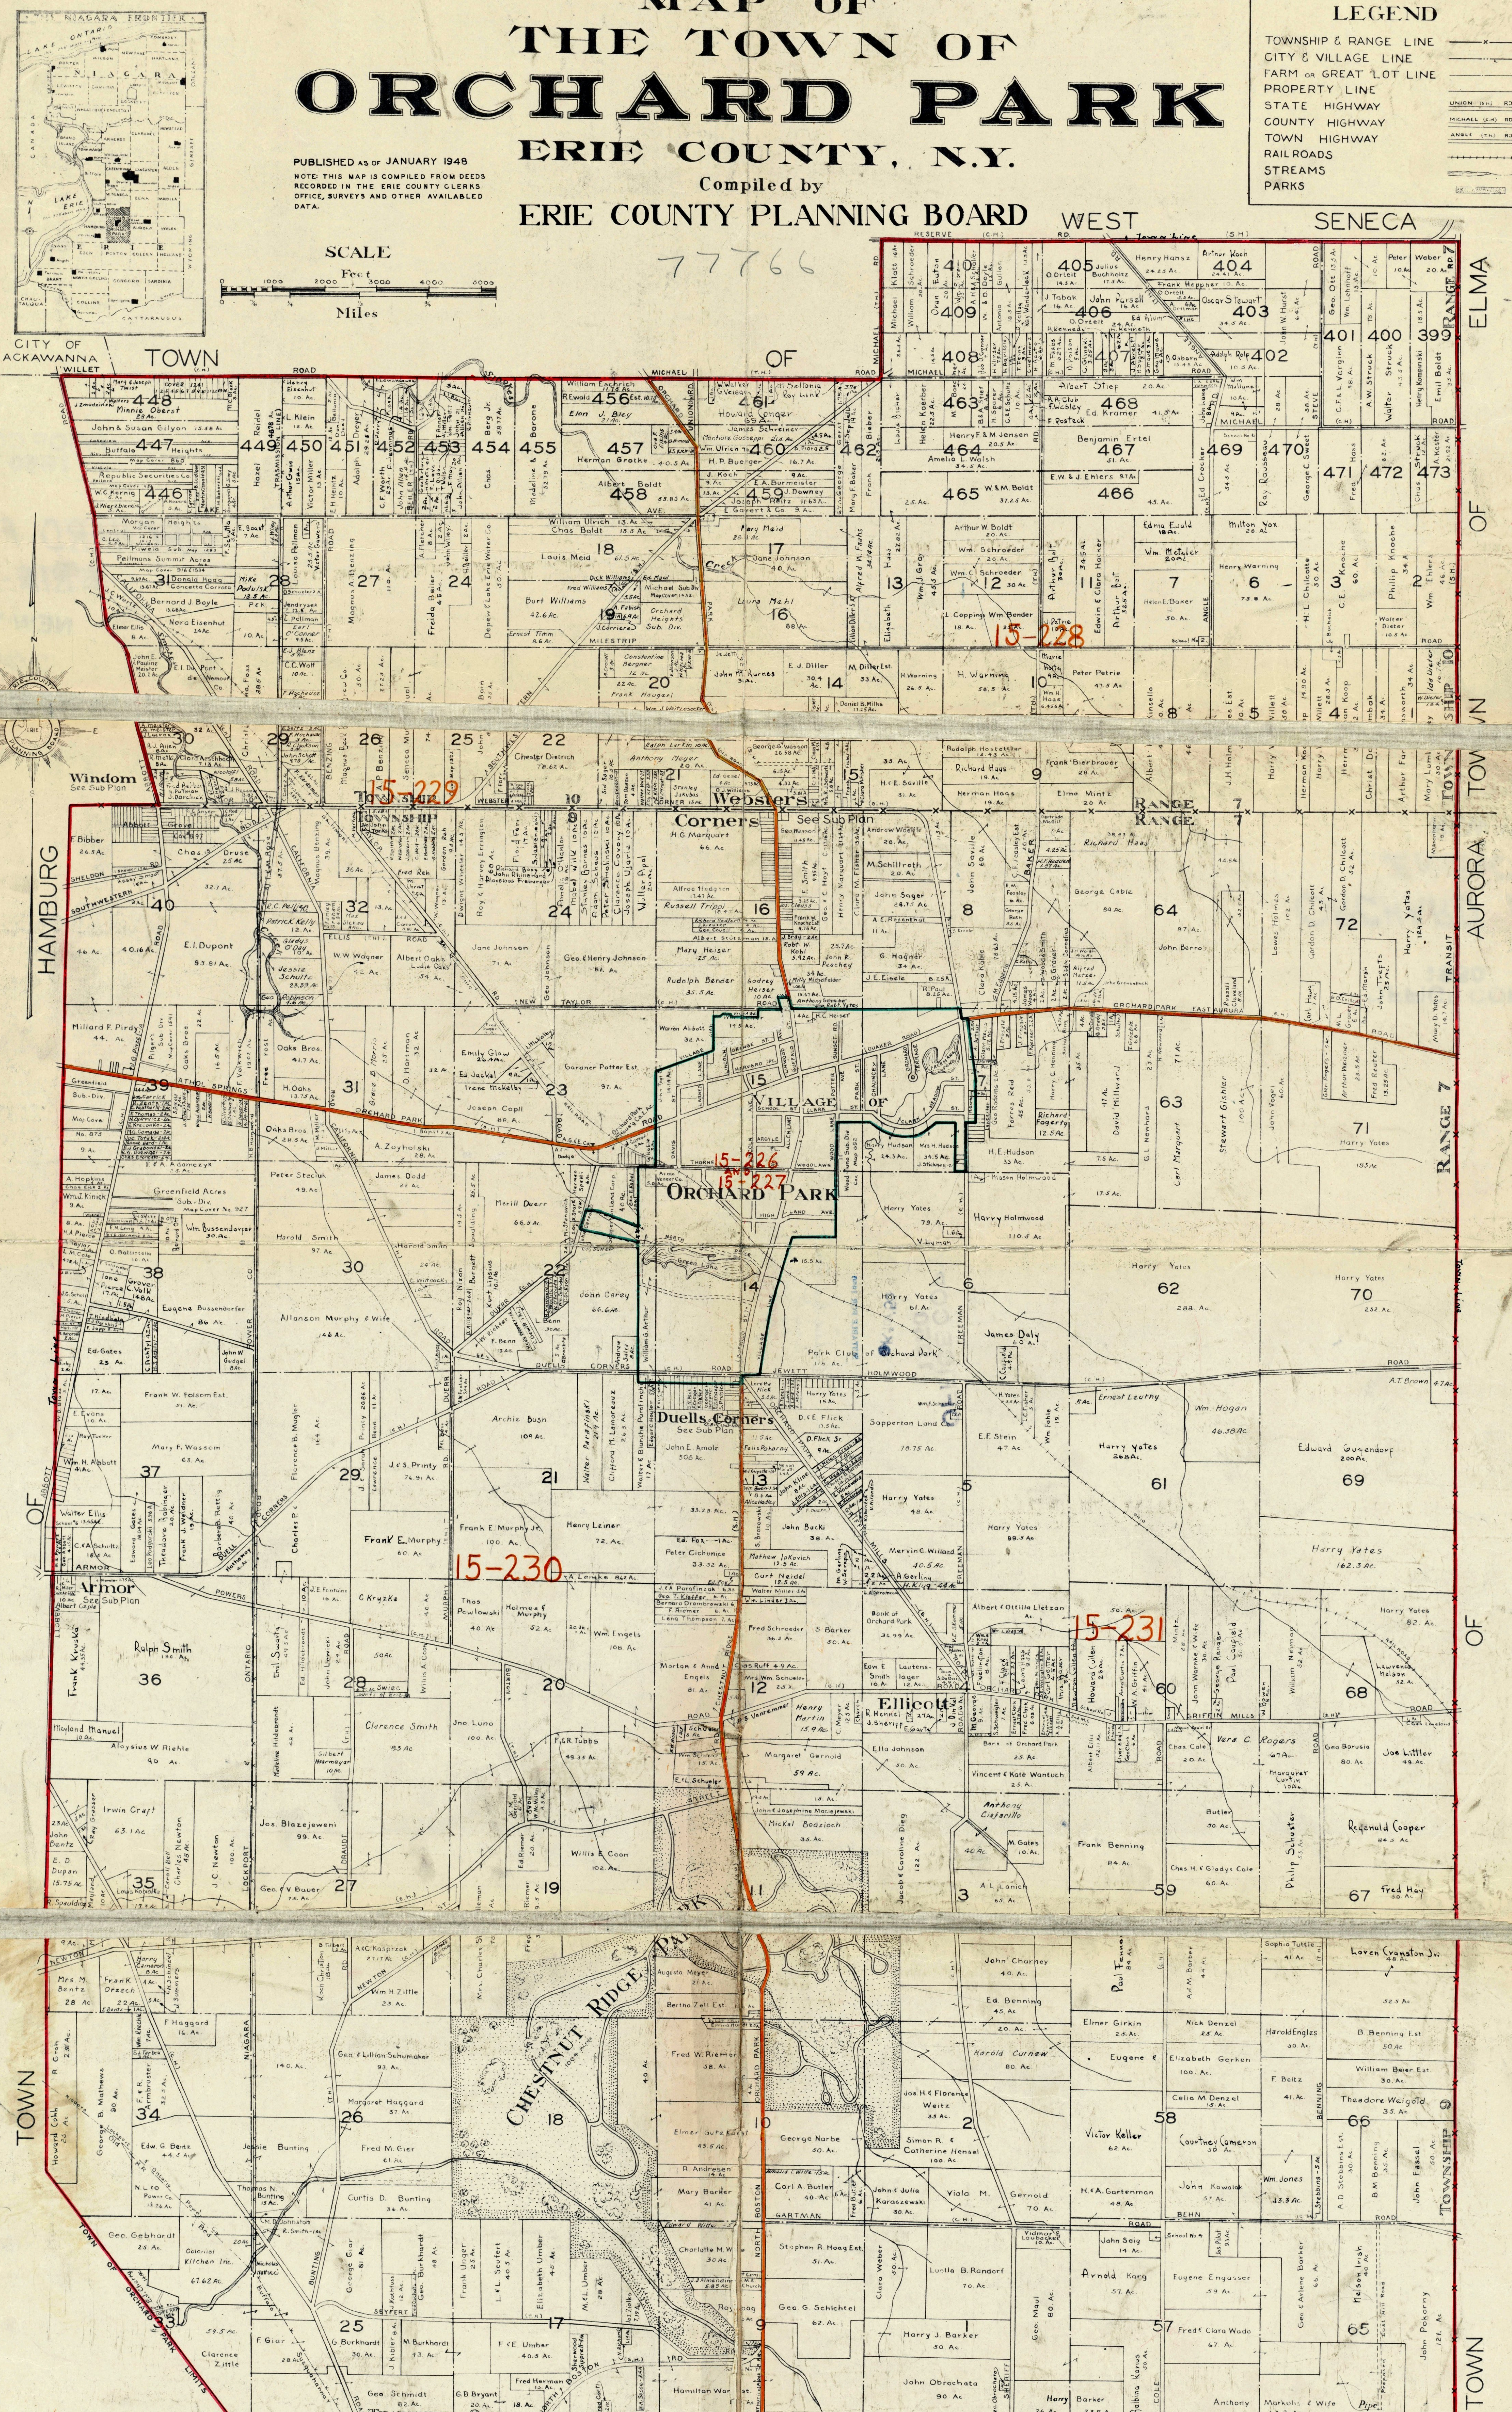

LEGEND

| | |
|---|---|
| TOWNSHIP & RANGE LINE | ——×—— |
| CITY & VILLAGE LINE | ——··—— |
| FARM OR GREAT LOT LINE | ——·—— |
| PROPERTY LINE | —— |
| STATE HIGHWAY | UNION (S.H.) RD. |
| COUNTY HIGHWAY | MICHAEL (C.H.) RD. |
| TOWN HIGHWAY | ANGLE (T.H.) RD. |
| RAIL ROADS | ++++++++ |
| STREAMS | ~~~ |
| PARKS | ▨ |

1950 E.D'S 15-226 TO 15-231
MCD (TOWN)____(RED) 🟥
INCORPORATED PLACE________(GREEN) 🟩
ENUMERATION DISTRICT________(ORANGE) 🟧

ENTIRELY WITHIN BUFFALO URBANIZED AREA

SHEET 1 OF 2

**1950 OFFICE MAP**

# VILLAGE OF SLOAN
## TOWN OF CHEEKTOWAGA
## ERIE COUNTY, N.Y.

Compiled by the
NIAGARA FRONTIER PLANNING BOARD
1939

WORKS PROGRESS ADMINISTRATION
MAPPING PROJECT
SPONSORED BY
ERIE COUNTY BOARD OF SUPERVISORS

LEGEND
VILLAGE LIMITS GREEN ———

SCALE 0 100 200 300 400 FEET

MAR 30 1948

NOTE: This map is compiled from records filed in the Erie County Clerks office and from other available information. It is an atlas map and is not to be used for surveying or other precise purposes.

Dotted lines dividing subdivision lots are the original subdivision lot boundaries.

Boundaries of Cover Map areas are shown thus — —

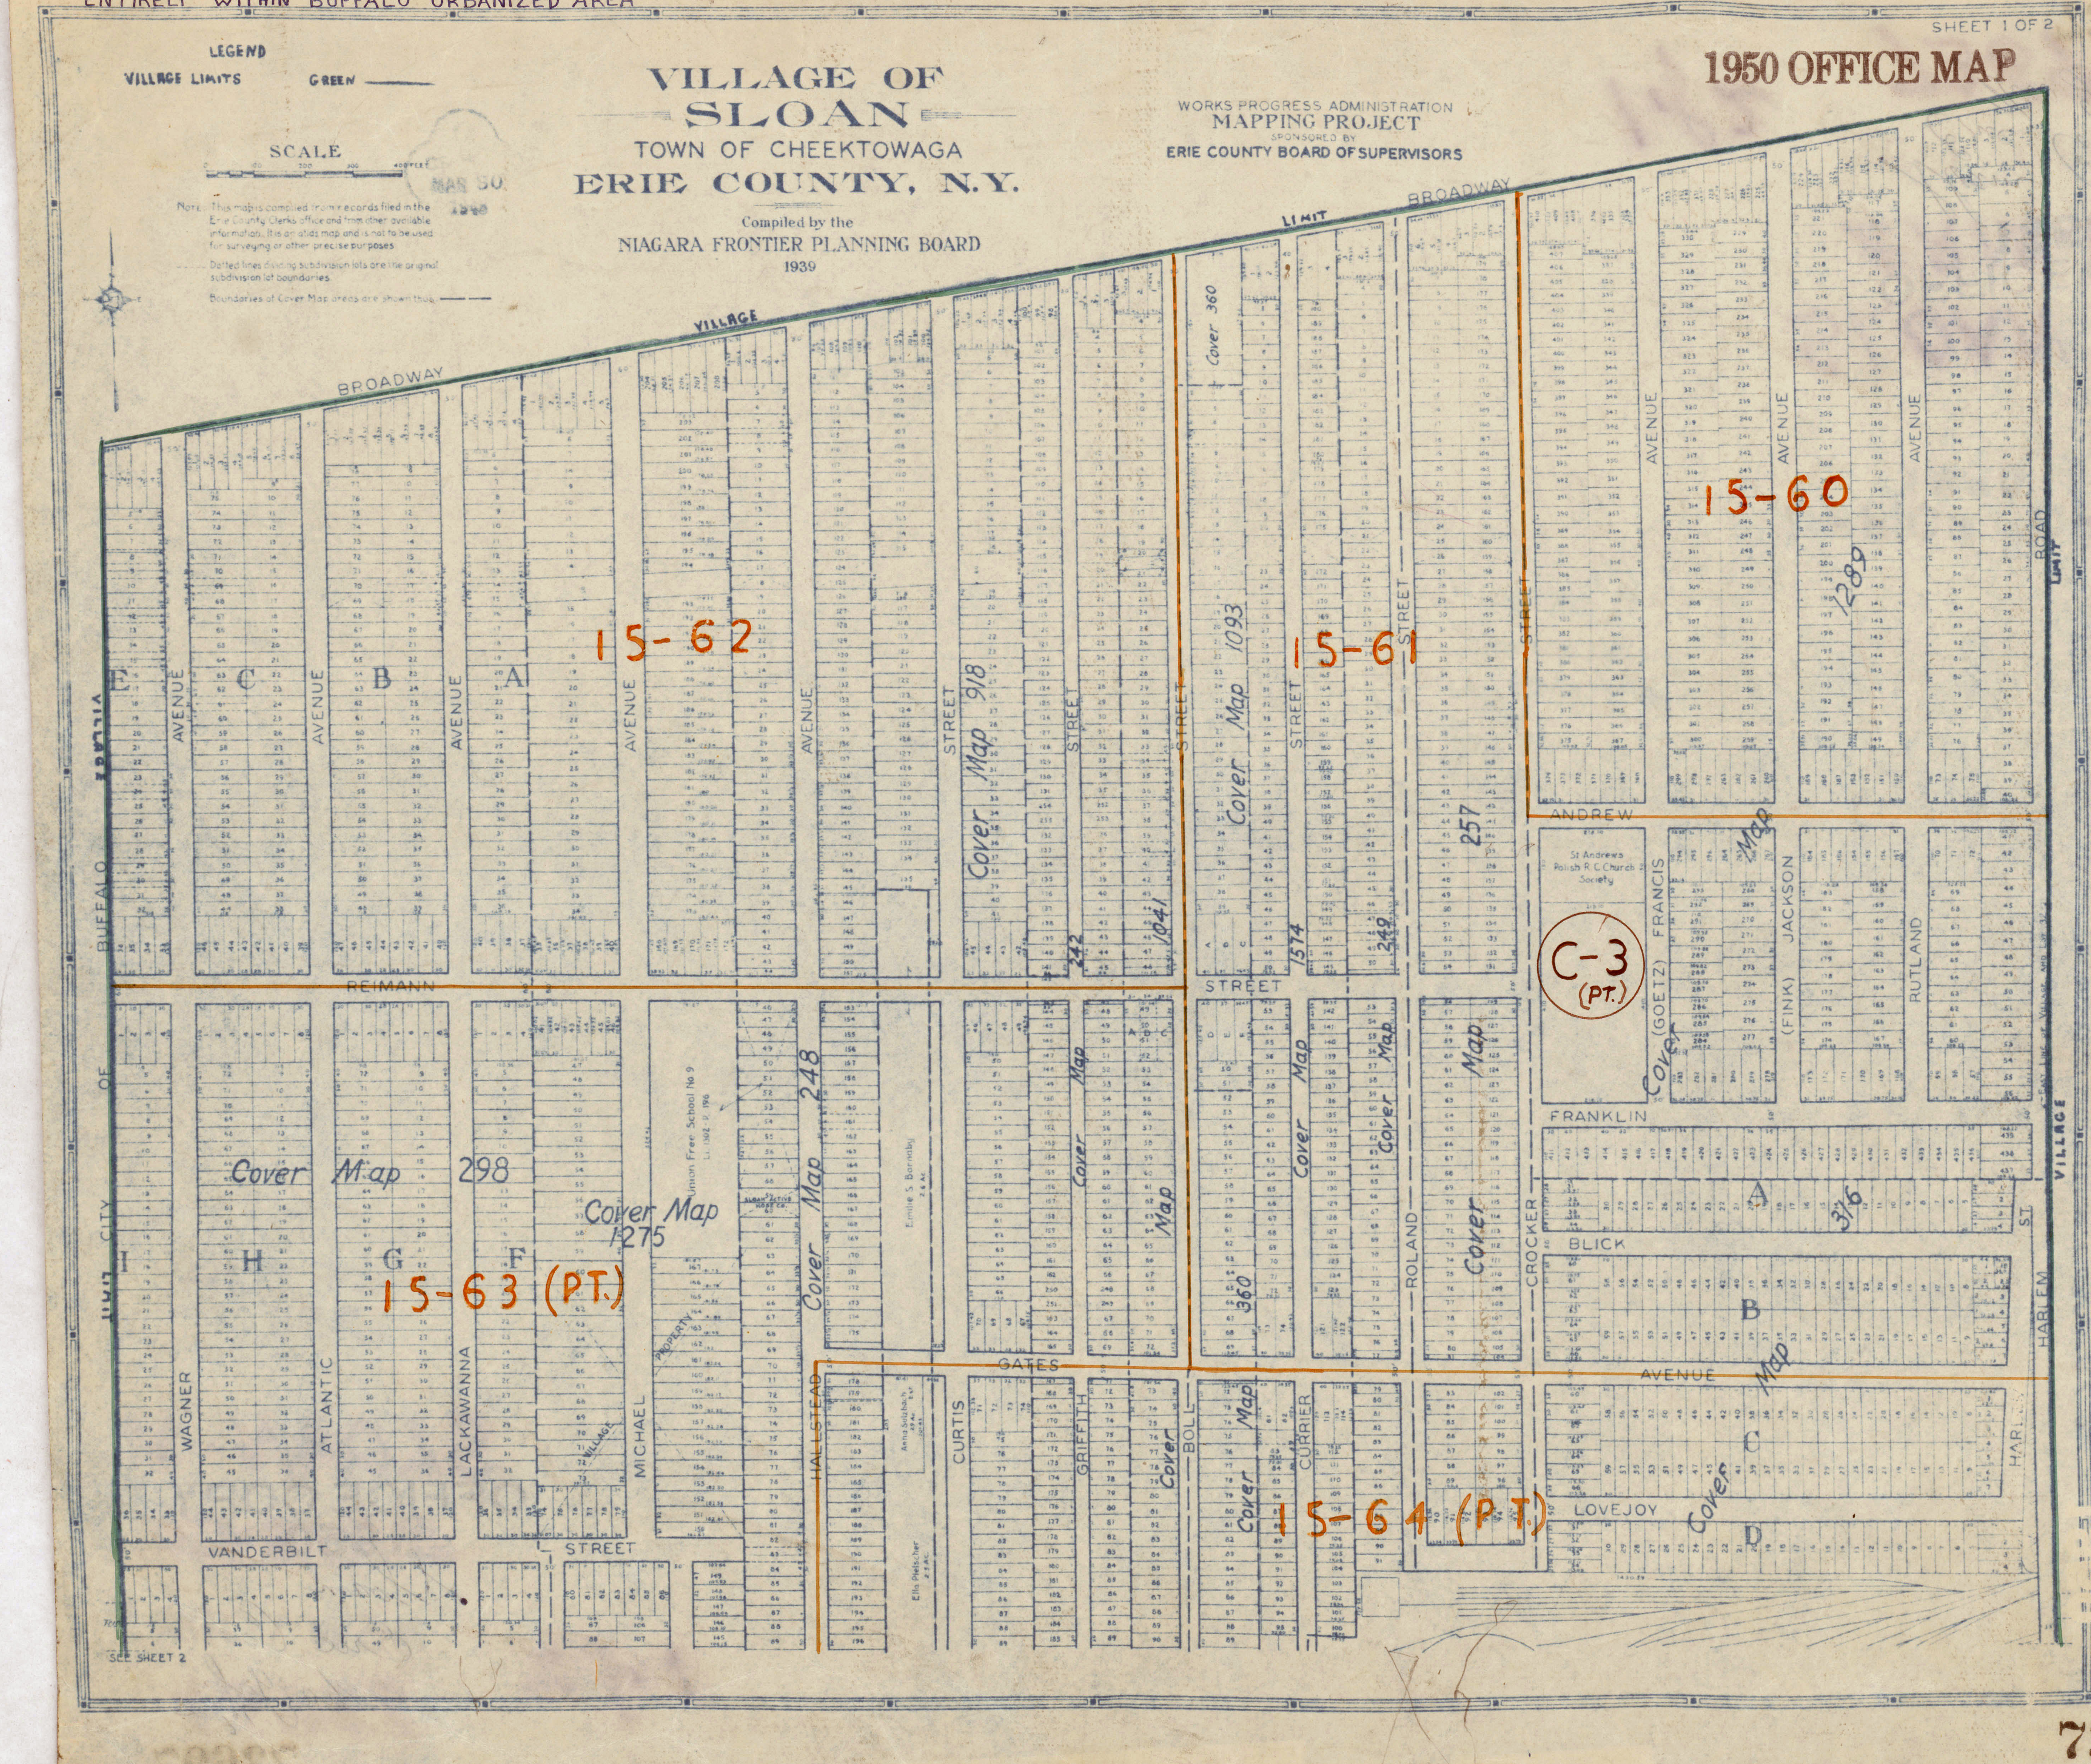

DUPLICATE COPY OF ORIGINAL 1950 OFFICE MAP PREPARED BY- Marsh
VERIFIED TO ORIGINAL 1950 OFFICE MAP AND E.D. DESCRIPTIONS BY- Blanchard
DATE COPY WAS MADE - MAY 21, 1951

1950 E.D'S 15-60 TO 15-64
CORPORATE LIMITS ———(GREEN)
ENUMERATION DISTRICT ———(ORANGE)
CENSUS TRACT C-3 (BROWN)

73697

73697 1 of 2

ENTIRELY WITHIN BUFFALO URBANIZED AREA

OFFICE COPY 1950

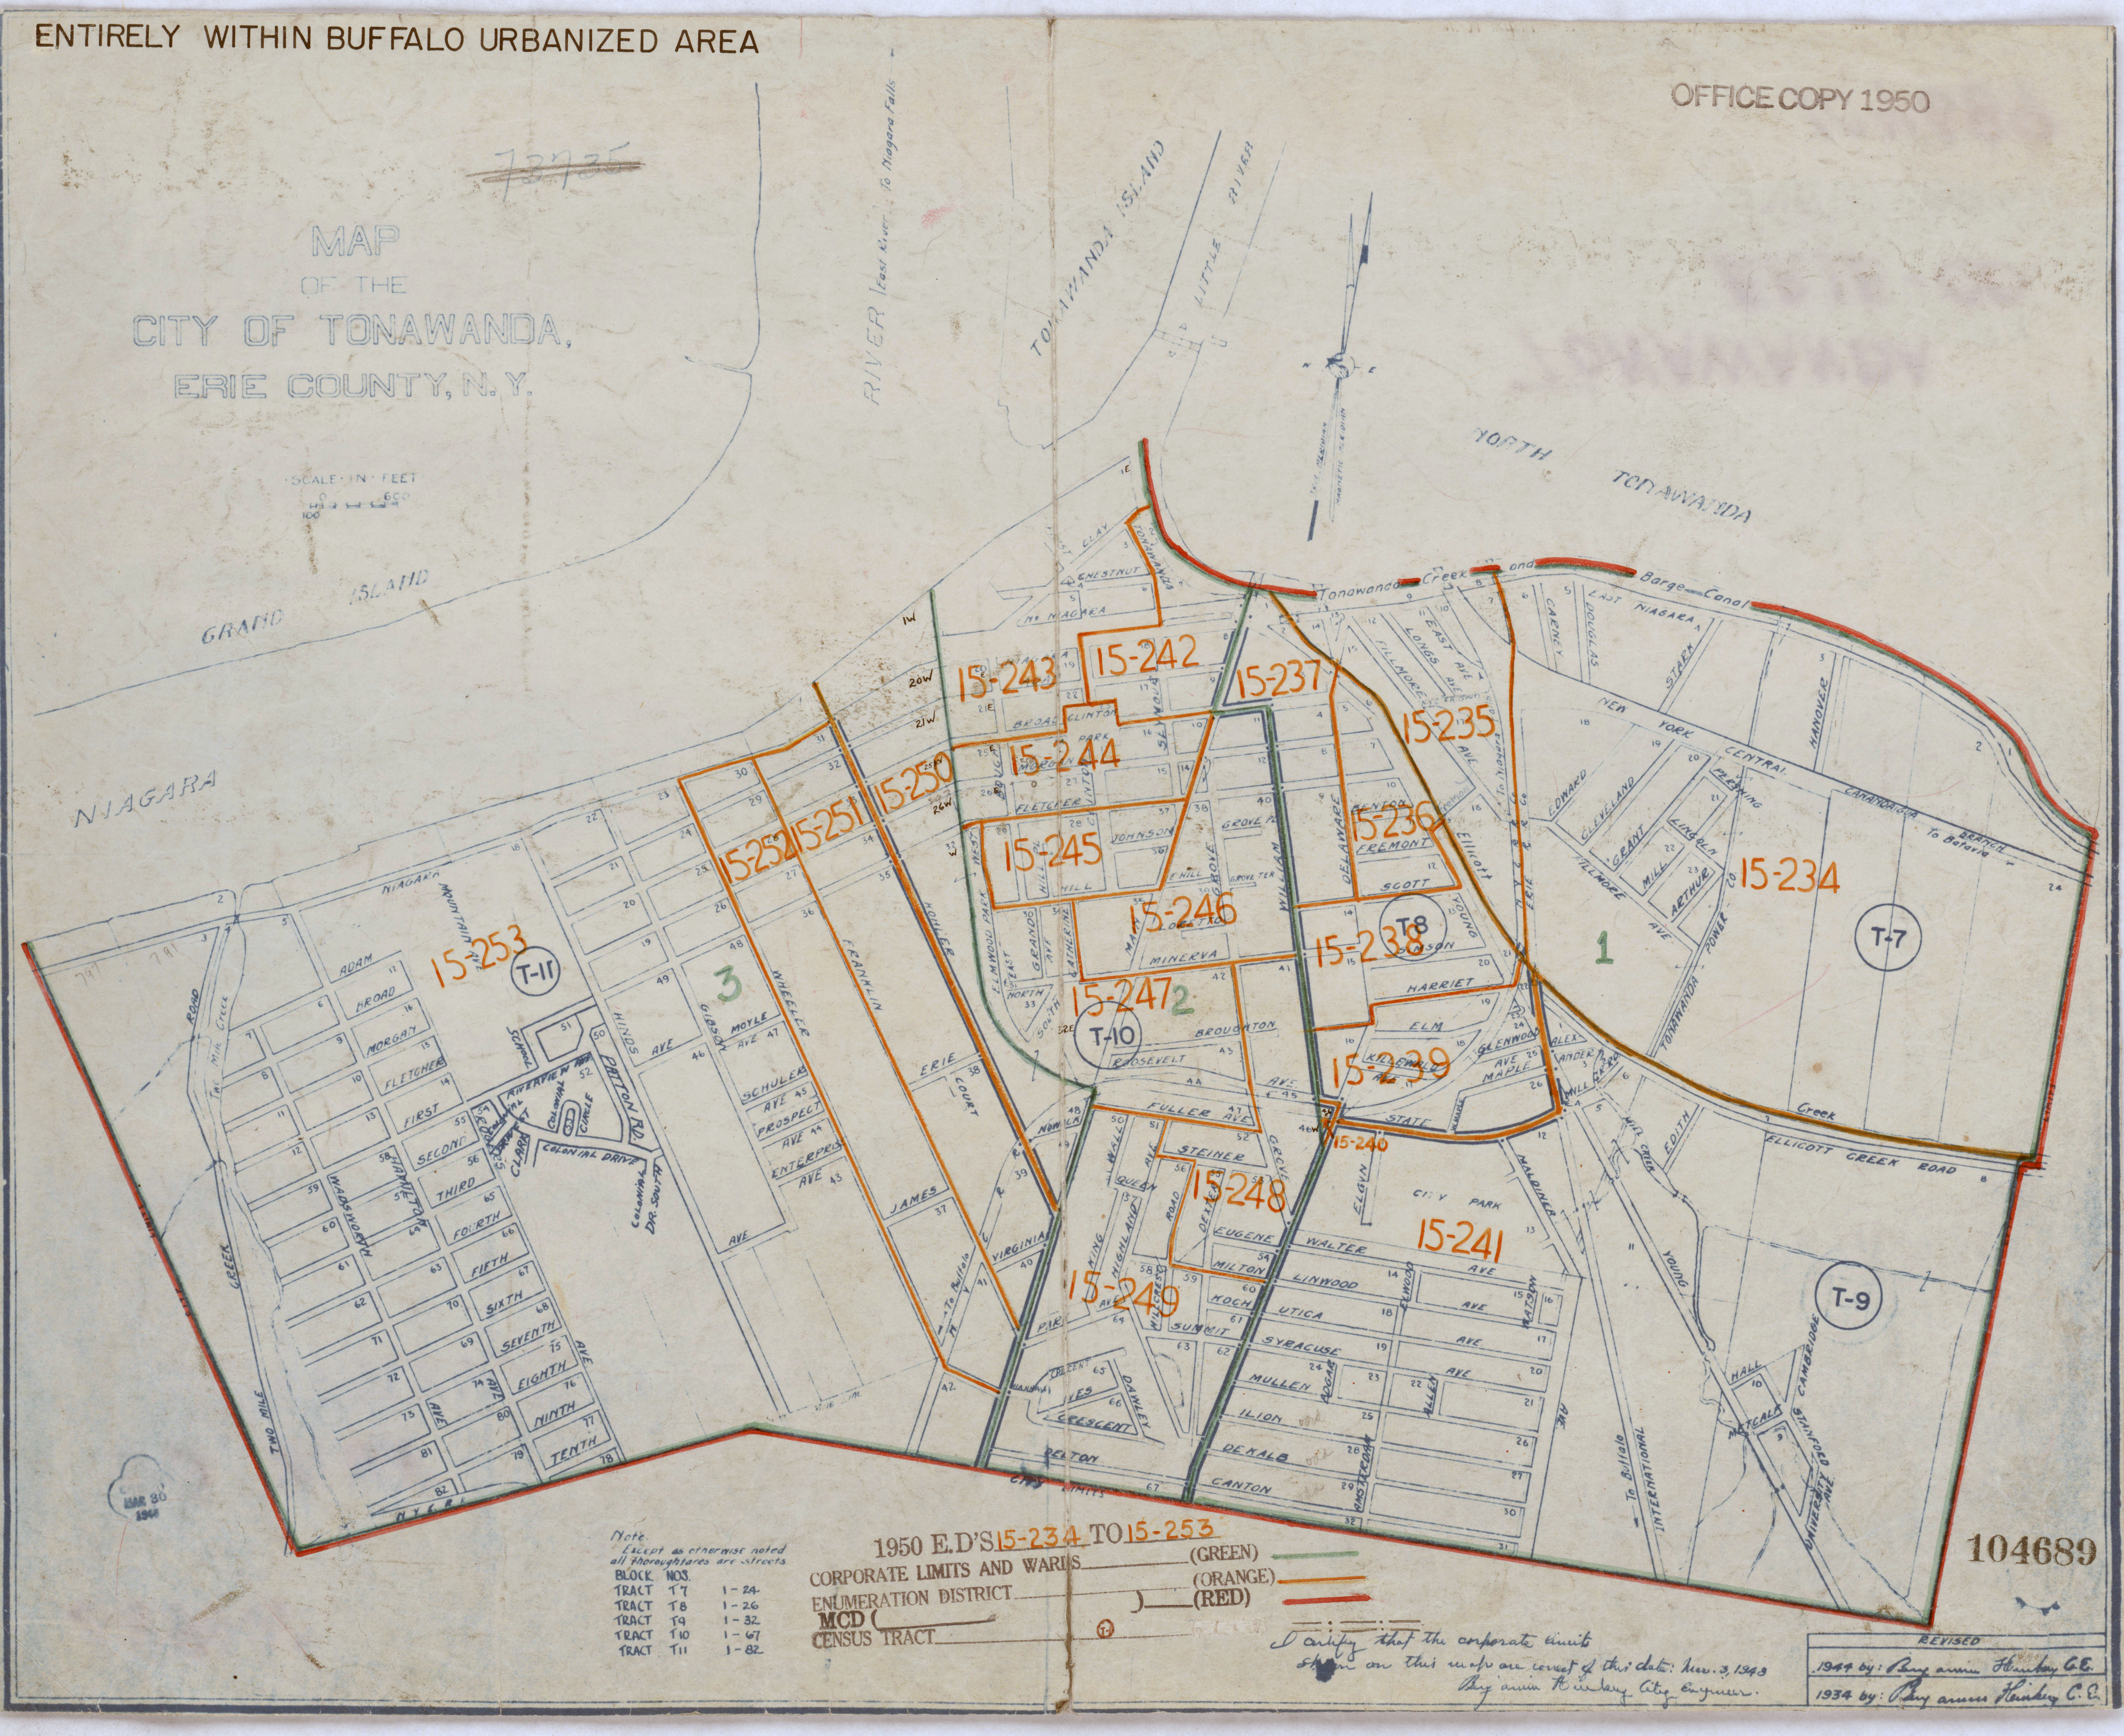

1950 E.D'S 15-234 TO 15-253

CORPORATE LIMITS AND WARDS ________ (GREEN)

ENUMERATION DISTRICT ________ (ORANGE)

MCD ( ________ ) ________ (RED)

CENSUS TRACT ________ T-

Note
Except as otherwise noted all thoroughfares are streets

| BLOCK | NOS. | |
|---|---|---|
| TRACT | T7 | 1 - 24 |
| TRACT | T8 | 1 - 26 |
| TRACT | T9 | 1 - 32 |
| TRACT | T10 | 1 - 67 |
| TRACT | T11 | 1 - 82 |

I certify that the corporate limits shown on this map are correct of this date: Nov. 3, 1949
Benjamin Hinkey City Engineer.

| REVISED |
|---|
| 1944 by: Benjamin Hinkey C.E. |
| 1934 by: Benjamin Hinkey C.E. |

104689

A

PARTLY WITHIN BUFFALO URBANIZED AREA

1950 OFFICE MAP

B

# MAP OF THE TOWN OF TONAWANDA

## ERIE COUNTY, N.Y.

Compiled by
ERIE COUNTY PLANNING BOARD

SPECIAL ENUMERATION AREAS

15-298 MOUNT SAINT MARY— PROVINCIAL HOUSE AND NOVITIATE OF THE SISTERS OF ST. MARY OF NAMUR, INC.

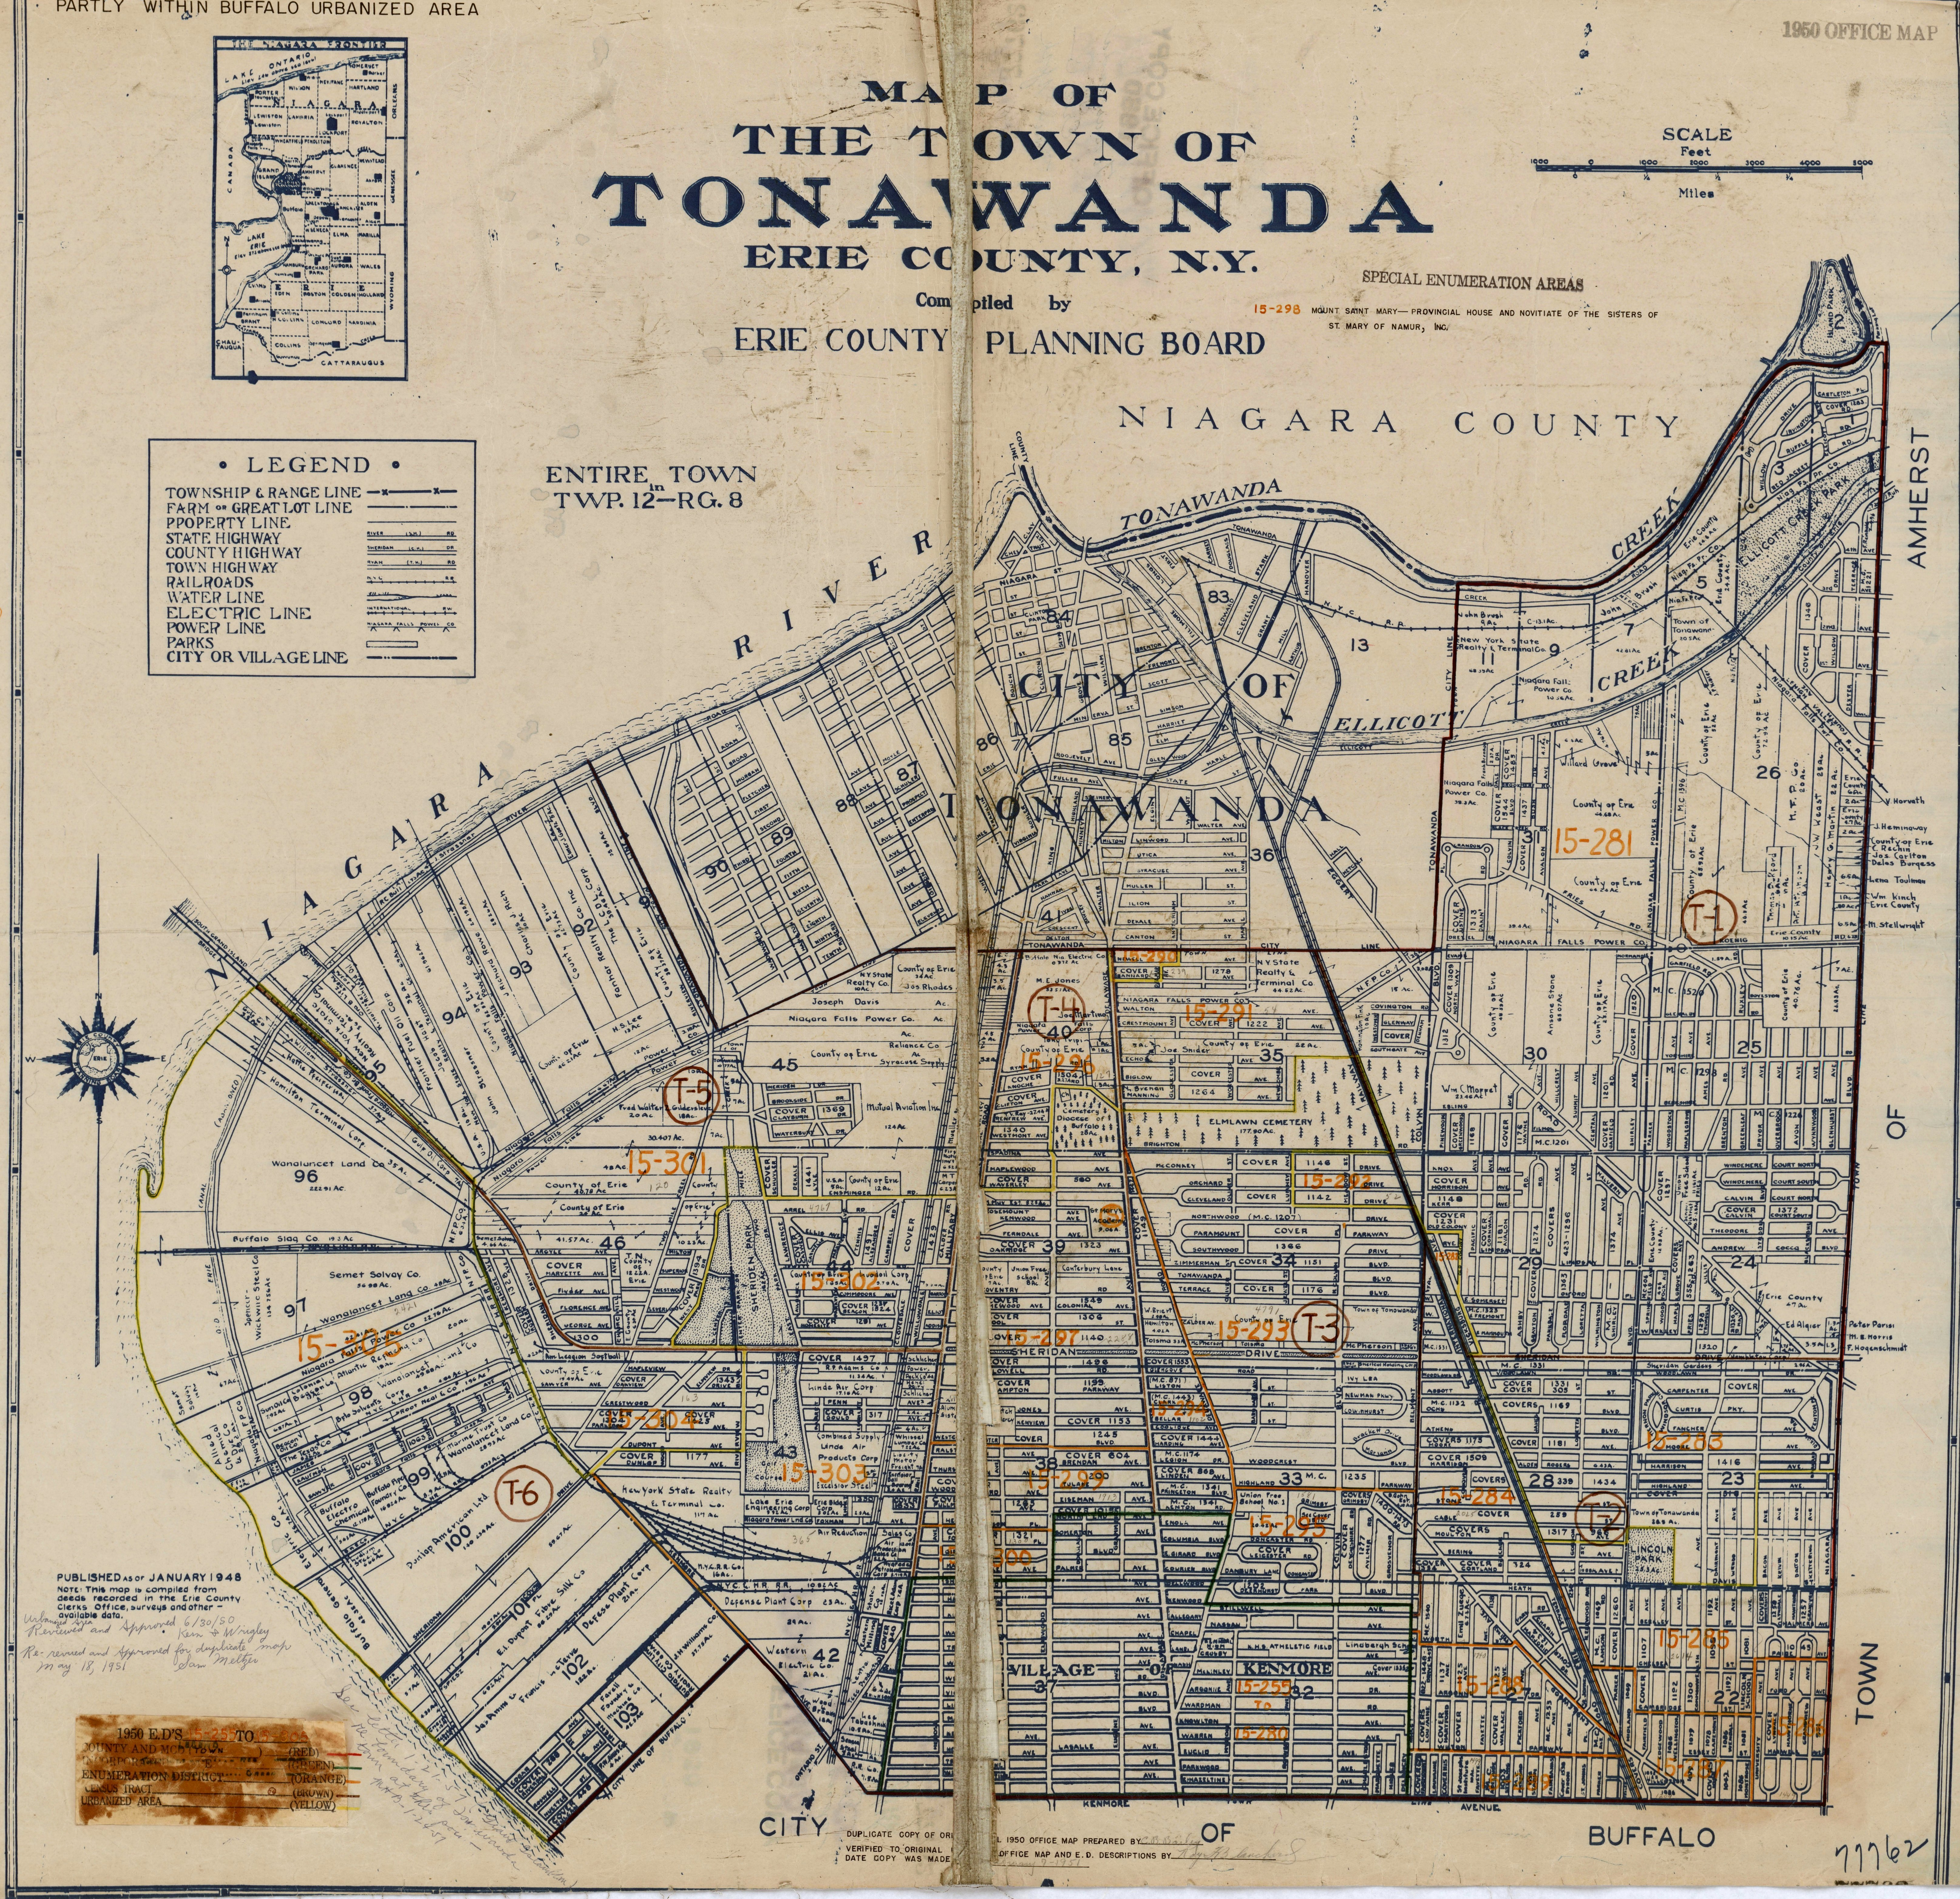

PUBLISHED AS OF JANUARY 1948
NOTE: This map is compiled from deeds recorded in the Erie County Clerks Office, surveys and other - available data.

Urbanized Area Reviewed and Approved 6/30/50 Kern & Wrigley
Re-revised and Approved for duplicate map May 18, 1951 Sam Meltzer

1950 E.D'S 15-255 TO 15-305
LEGEND
COUNTY AND MCD (TOWN) (RED)
INCORPORATED PLACE (GREEN)
ENUMERATION DISTRICT (ORANGE)
CENSUS TRACT (BROWN)
URBANIZED AREA (YELLOW)

See letter 1-21-57 (Grand Island) re boundary of Tonawanda town at this point - MHB-1-24-57

DUPLICATE COPY OF ORI L 1950 OFFICE MAP PREPARED BY C.B. Bailey
VERIFIED TO ORIGINAL OFFICE MAP AND E.D. DESCRIPTIONS BY Roy H. Blanchard
DATE COPY WAS MADE ruary 7-1951

77762

PARTLY WITHIN BUFFALO URBANIZED AREA

1950 OFFICE MAP

# MAP OF THE TOWN OF WEST SENECA ERIE COUNTY, N.Y.

Reproduced by
ERIE COUNTY PLANNING BOARD

77767

**LEGEND**

| | |
|---|---|
| TOWNSHIP & RANGE | —×— |
| FARM & GREAT LOT LINE | —·— |
| PROPERTY LINE | |
| STATE HIGHWAY | (S.H.) RD |
| COUNTY HIGHWAY | (C.H.) RD |
| TOWN HIGHWAY | (T.H.) |
| RAILROADS | -+-+-+- |
| POWER LINE | ▲▲▲▲ |
| WATER LINE | |

PUBLISHED AS OF JANUARY 1948
Note This map is compiled from deeds recorded in the County Clerk's Office, surveys and other available data

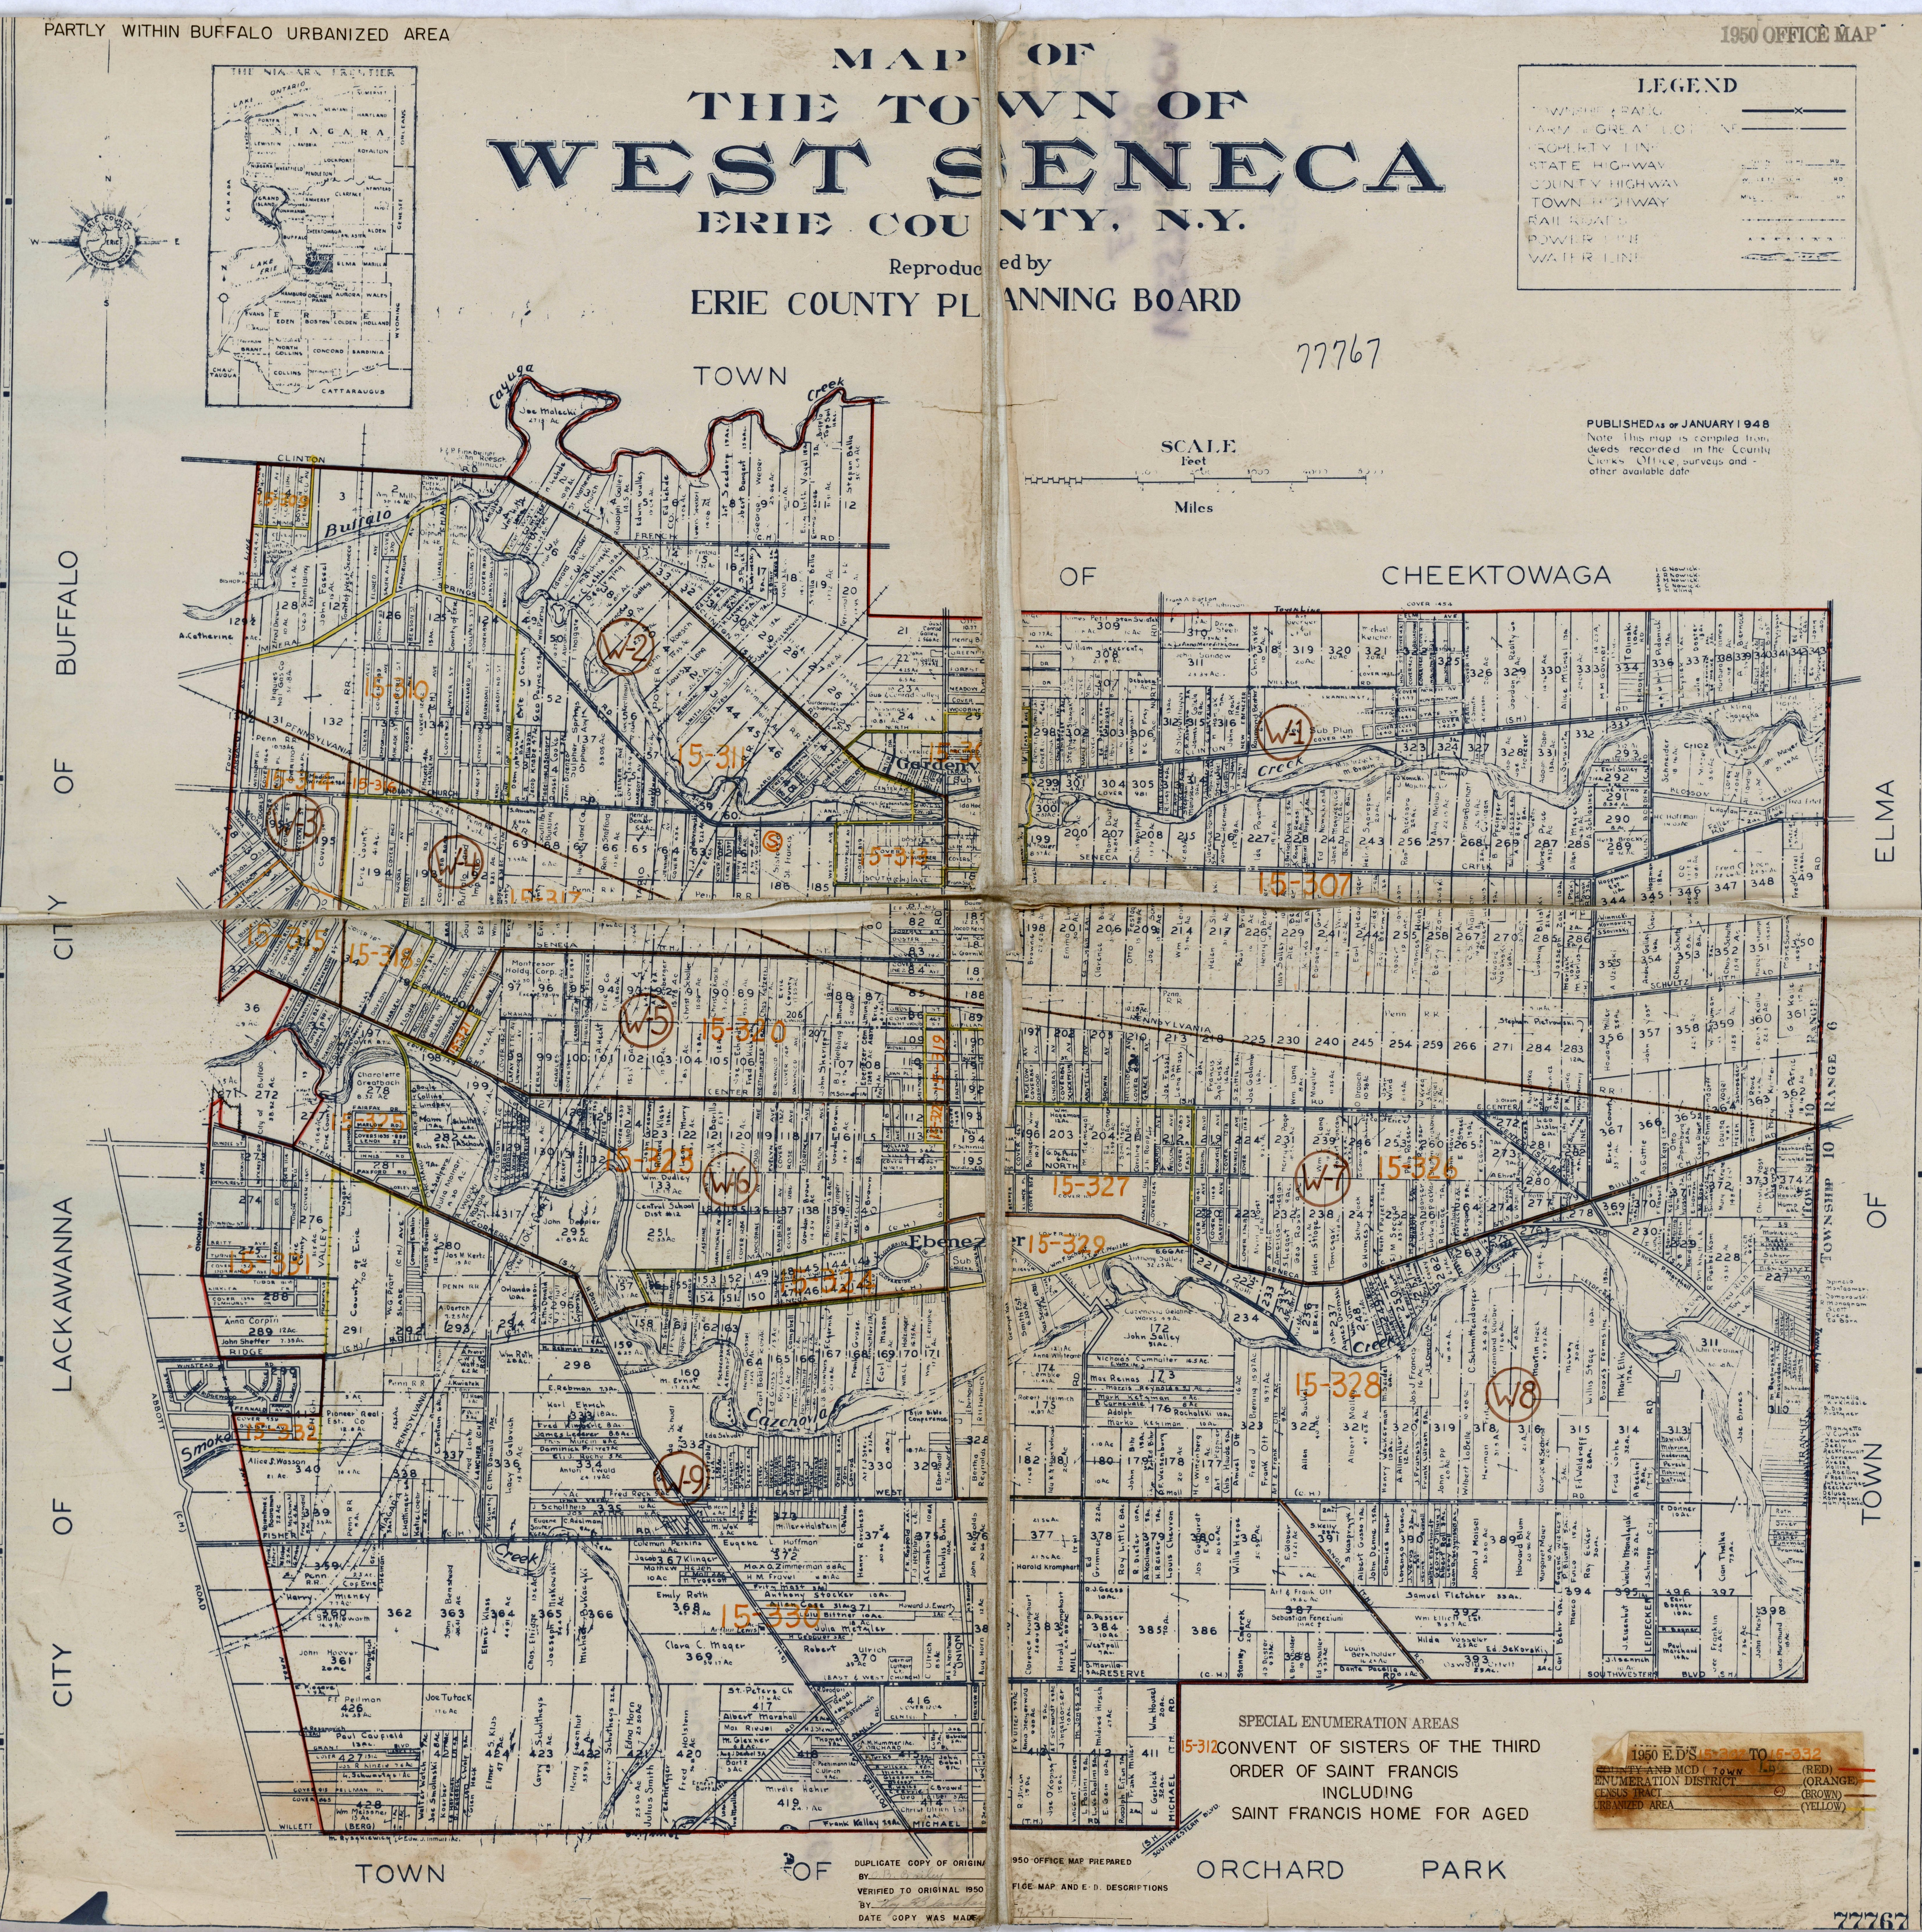

SPECIAL ENUMERATION AREAS

15-312 CONVENT OF SISTERS OF THE THIRD ORDER OF SAINT FRANCIS INCLUDING SAINT FRANCIS HOME FOR AGED

| | |
|---|---|
| 1950 E.D'S 15-307 TO 15-332 | |
| ~~COUNTY AND~~ MCD ( TOWN 1-9 ) | (RED) |
| ENUMERATION DISTRICT | (ORANGE) |
| CENSUS TRACT ○ | (BROWN) |
| URBANIZED AREA | (YELLOW) |

DUPLICATE COPY OF ORIGINAL 1950 OFFICE MAP PREPARED
BY C. B. Bailey
VERIFIED TO ORIGINAL 1950 OFFICE MAP AND E. D. DESCRIPTIONS
BY Roy B. Blanchard
DATE COPY WAS MADE 7-5-51

Urbanized Area boundary reviewed and approved 6/30/50 Kern & Wrigley

re-reviewed and approved on duplicate map May 18, 1951 Sam Meltzer

77767

77767

73731

ENTIRELY WITHIN BUFFALO URBANIZED AREA

OFFICE COPY 1950

# VILLAGE OF
# WILLIAMSVILLE
## ERIE COUNTY, N.Y.

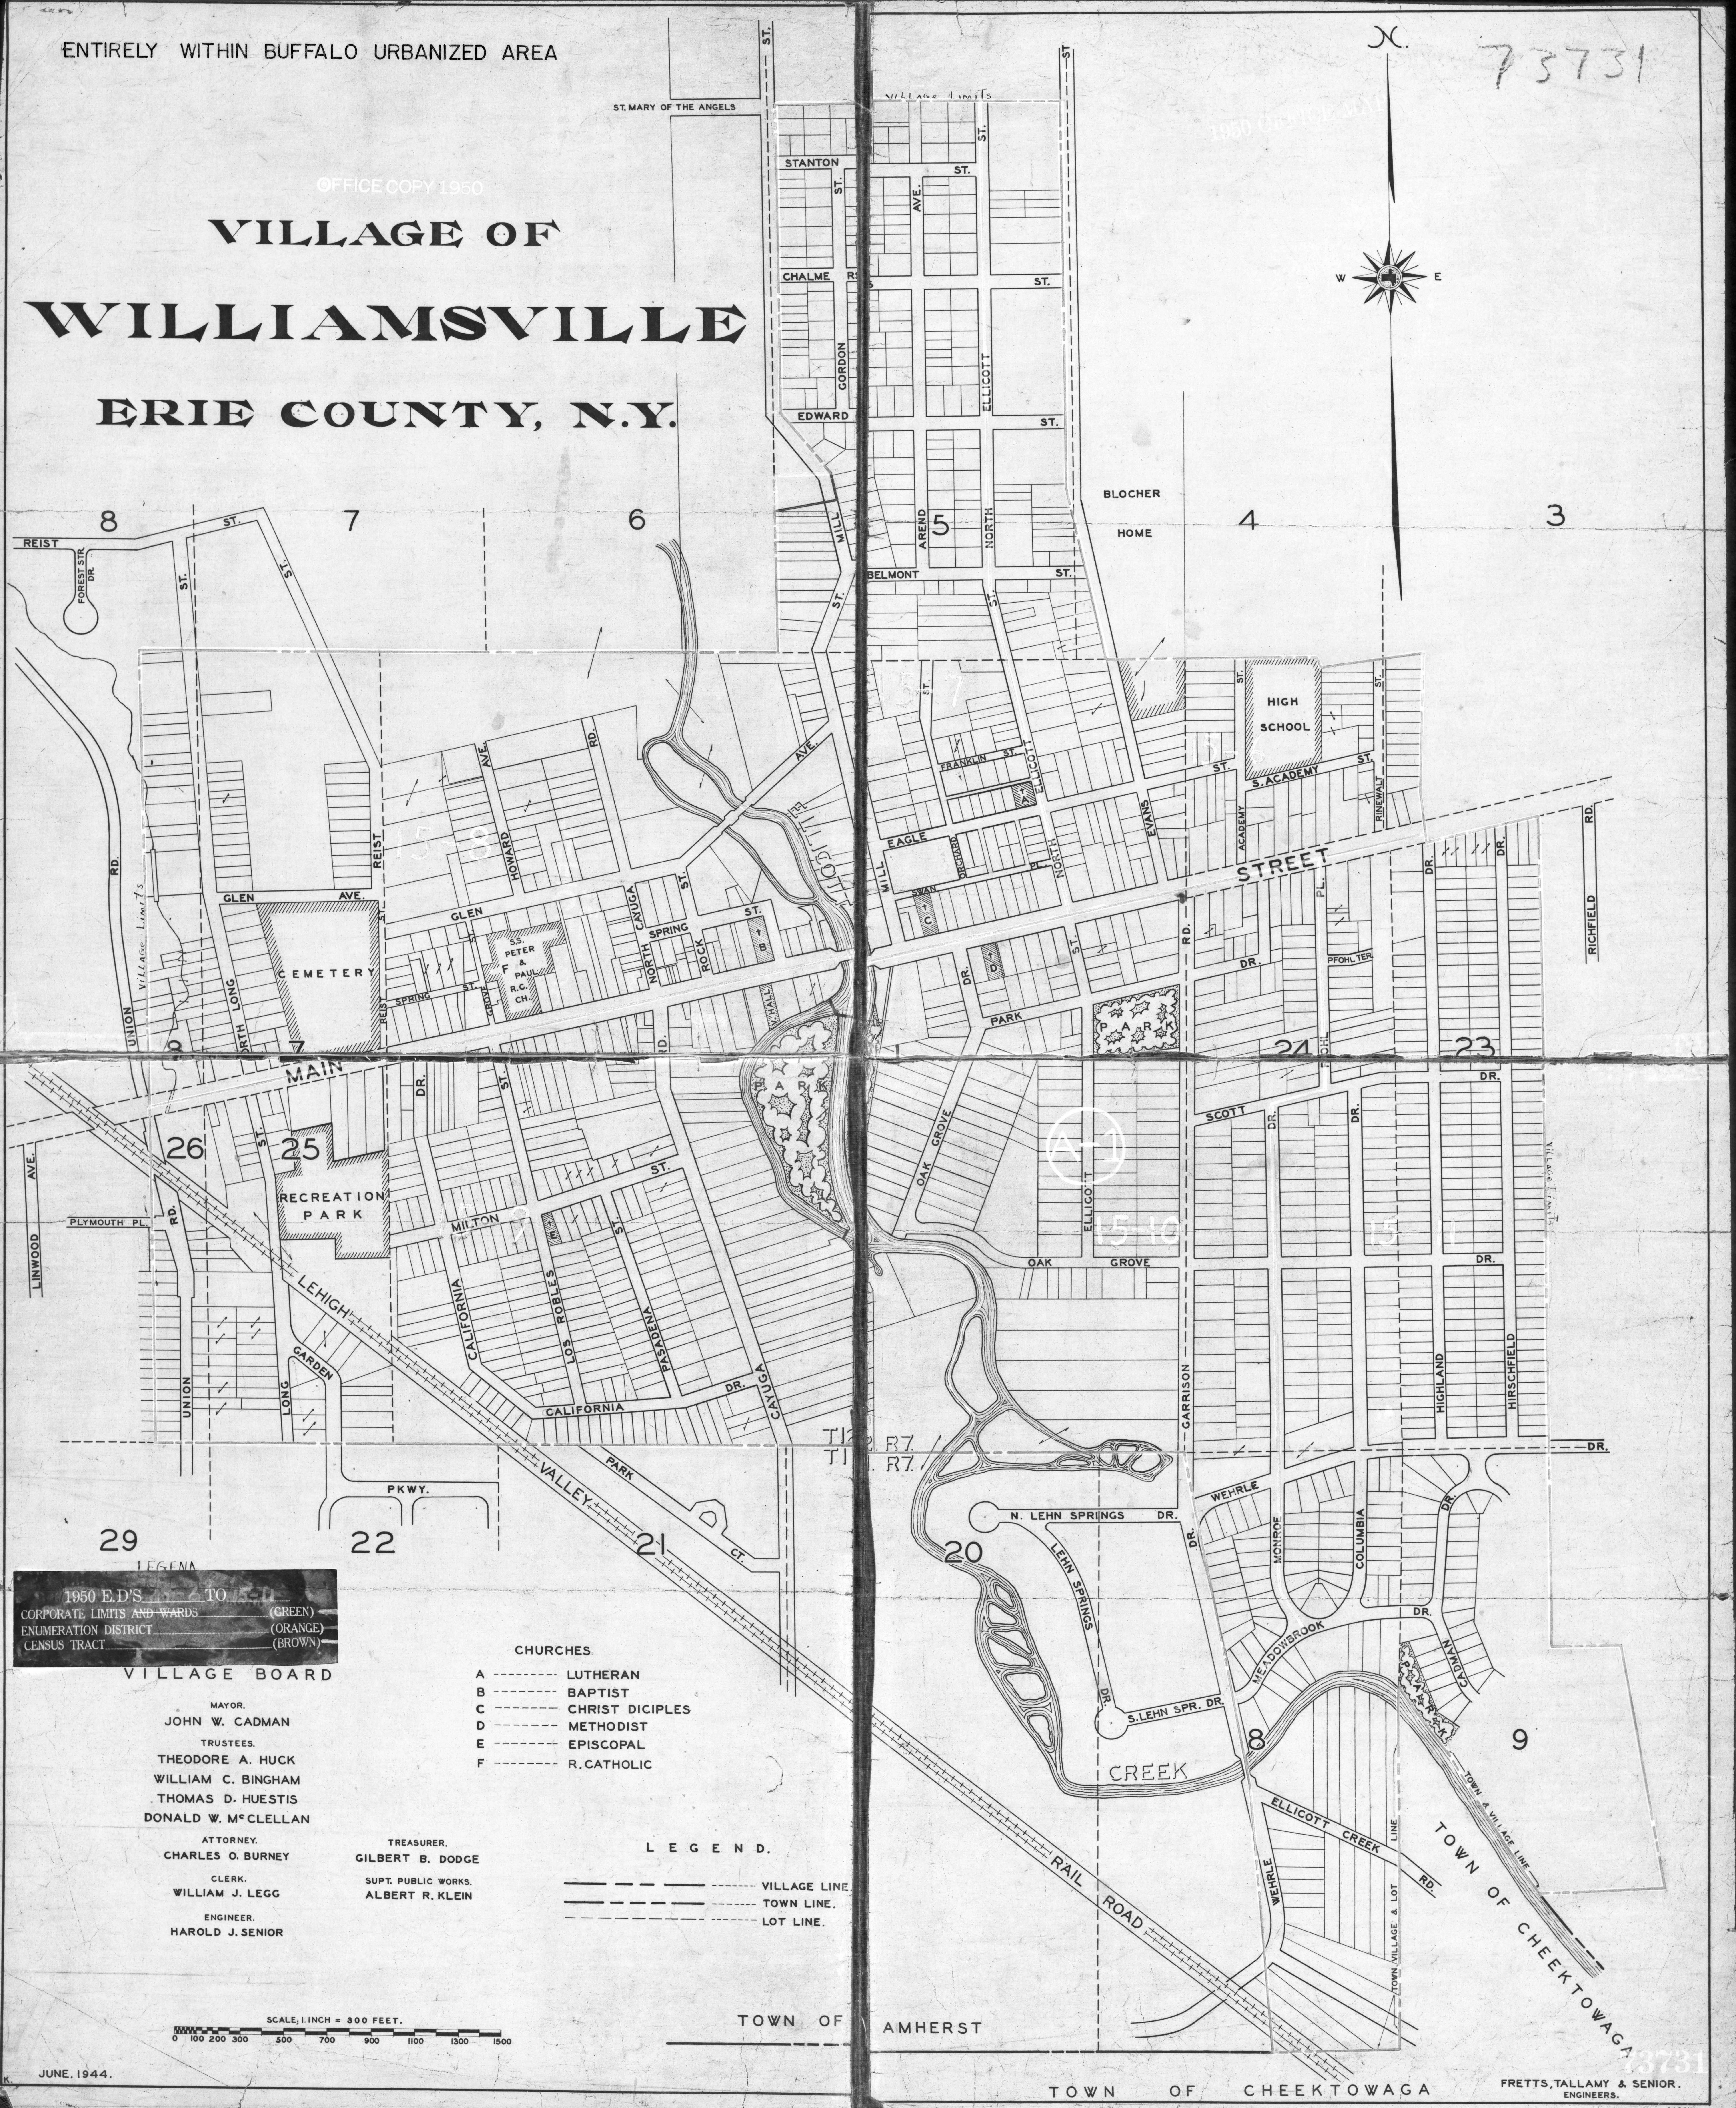

1950 E.D'S 15-6 TO 15-11
CORPORATE LIMITS ~~AND WARDS~~ (GREEN)
ENUMERATION DISTRICT (ORANGE)
CENSUS TRACT (BROWN)

## VILLAGE BOARD

MAYOR.
JOHN W. CADMAN

TRUSTEES.
THEODORE A. HUCK
WILLIAM C. BINGHAM
THOMAS D. HUESTIS
DONALD W. McCLELLAN

ATTORNEY.
CHARLES O. BURNEY

CLERK.
WILLIAM J. LEGG

ENGINEER.
HAROLD J. SENIOR

TREASURER.
GILBERT B. DODGE

SUPT. PUBLIC WORKS.
ALBERT R. KLEIN

CHURCHES

| | |
|---|---|
| A | LUTHERAN |
| B | BAPTIST |
| C | CHRIST DICIPLES |
| D | METHODIST |
| E | EPISCOPAL |
| F | R. CATHOLIC |

LEGEND.

VILLAGE LINE.
TOWN LINE.
LOT LINE.

SCALE; 1. INCH = 300 FEET.
0 100 200 300 500 700 900 1100 1300 1500

JUNE. 1944.

FRETTS, TALLAMY & SENIOR.
ENGINEERS.

4191.

73731

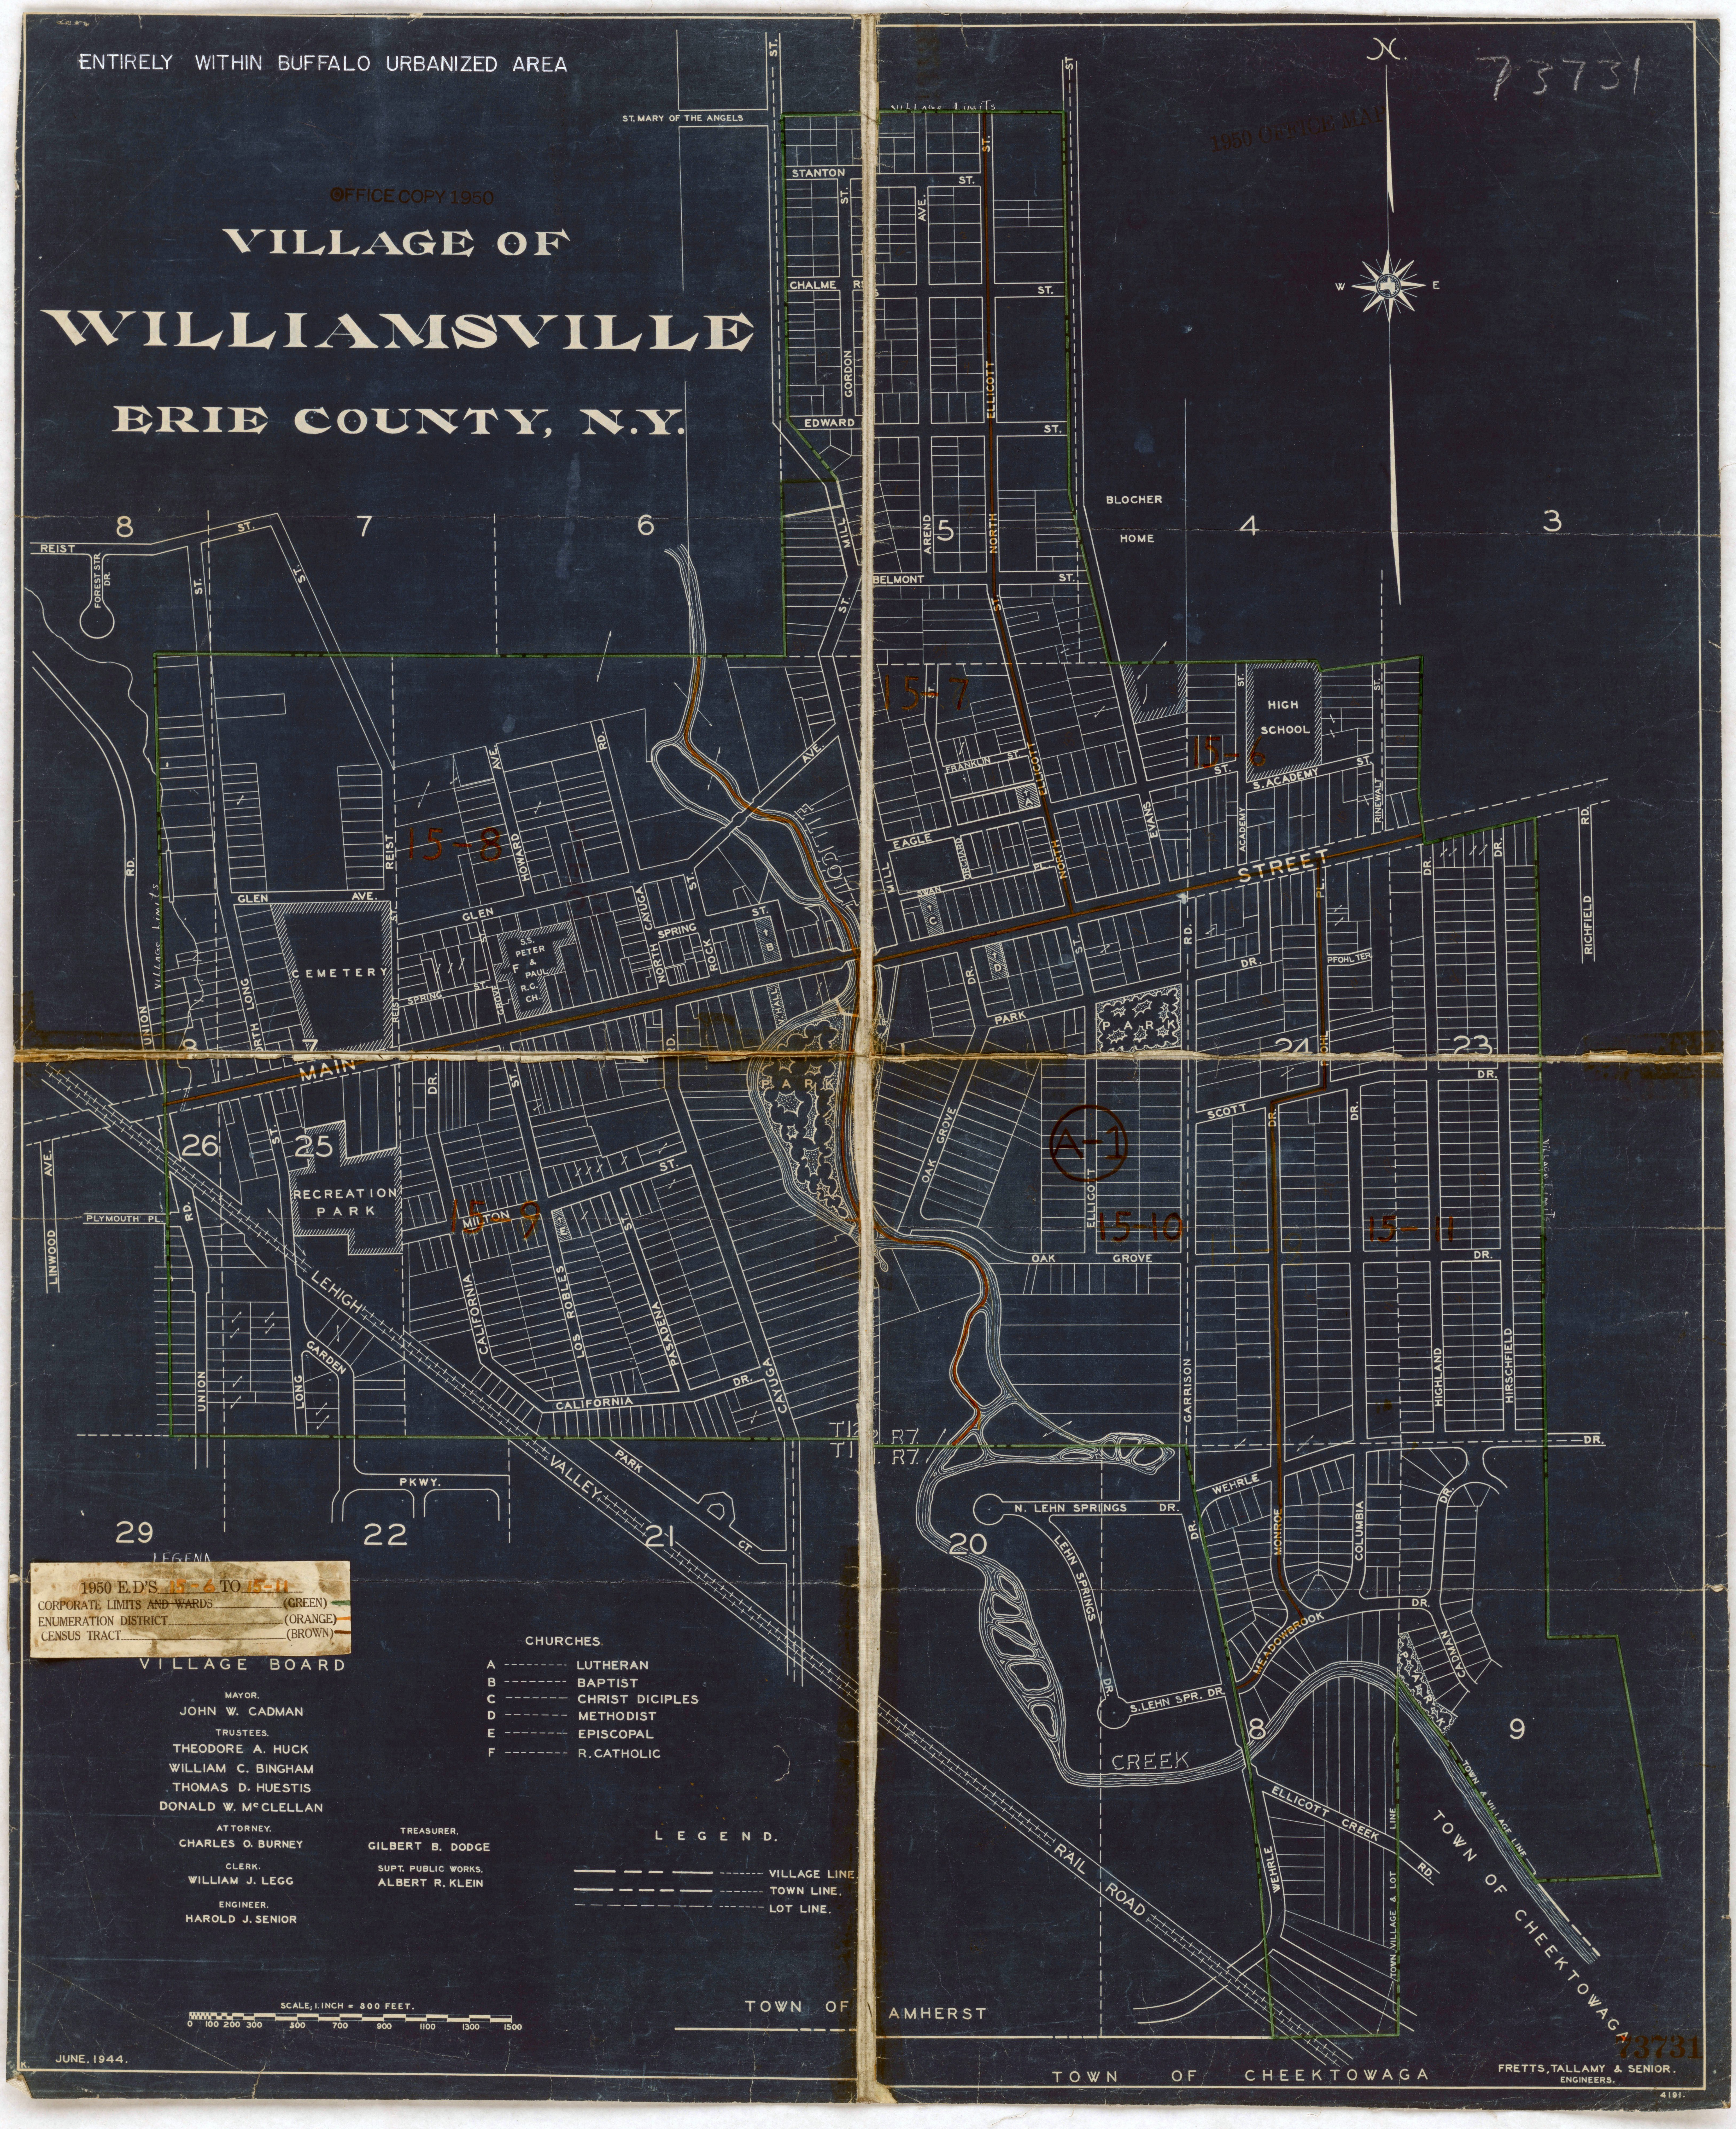

ENTIRELY WITHIN BUFFALO URBANIZED AREA

OFFICE COPY 1950

73731

1950 OFFICE MAP

# VILLAGE OF
# WILLIAMSVILLE
# ERIE COUNTY, N.Y.

1950 E.D'S 15-6 TO 15-11
CORPORATE LIMITS ~~AND WARDS~~ ........ (GREEN)
ENUMERATION DISTRICT ........ (ORANGE)
CENSUS TRACT ........ (BROWN)

VILLAGE BOARD

MAYOR.
JOHN W. CADMAN

TRUSTEES.
THEODORE A. HUCK
WILLIAM C. BINGHAM
THOMAS D. HUESTIS
DONALD W. McCLELLAN

ATTORNEY.
CHARLES O. BURNEY

CLERK.
WILLIAM J. LEGG

ENGINEER.
HAROLD J. SENIOR

TREASURER.
GILBERT B. DODGE

SUPT. PUBLIC WORKS.
ALBERT R. KLEIN

CHURCHES.

A -------- LUTHERAN
B -------- BAPTIST
C -------- CHRIST DICIPLES
D -------- METHODIST
E -------- EPISCOPAL
F -------- R. CATHOLIC

LEGEND.

------- VILLAGE LINE.
------- TOWN LINE.
------- LOT LINE.

SCALE, 1 INCH = 300 FEET.

JUNE, 1944.

FRETTS, TALLAMY & SENIOR.
ENGINEERS.

4191.

73731